
FORM 51 – McPherson KANSAS

Section 21 Township 18 Range 1 W

Well No. # 1 State ~~"A"~~ "B"

Company Glickman Oil

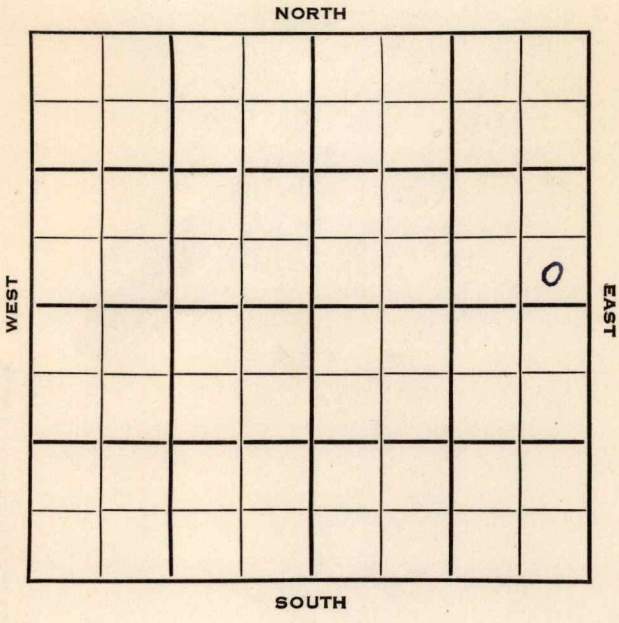

8

FORM 252-B
10M 10-50 PETROL

KANSAS

Sec. 21 Twp. 18 McPherson R. 1W

Well No. #1 State "A" "B" Farm

Glickman Oil Company

Barnett Drlg. Contractor


____ Ft. from N. Line

330 Ft. from S. Line

330 Ft. from E. Line

____ Ft. from W. Line

SE SE NE

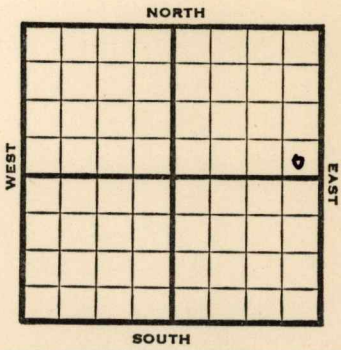

1953	Elev. 1416' REPORT
5/20	spud 5-17-53 8" @ 104
5/28	Drlg 2725'
6/3	Heeb 1938, Br. L. 2108, Lans 2159, Chat 2742, DST 2742-48 ½ hr, 30' M 430# 5" @ 2743' TD 2752'
6/10	CO 2752 B/ 10 goph 500 A s/2¼ BO / ¼ bwph
6/24	Spud 5-17-53 Oil well TD 2752 8" @ 104 Heeb 1938 Br lime 2108 Lans 3159 Chat 2742 DST 2742-48 open ½ hr rec 30' mud 430# 5" @ 2743 TD 2752 CO to 2752 B/10 GOPH 500 A S/2¼ BO ¼ BWPH Comp. 30 BOPD

COMPLETED

FORM 275 FOR SALE BY KANSAS BLUE PRINT CO.

County McPherson State Kansas

Sec. 21 (Blk. Twp.) 18 (Sur. Rge.) 1W Map No.

Operator Glickman Oil

Well No. 1 Farm State "A"

Elev. Location SE SE NE



330 Ft. From S Line NE

330 Ft. From E Line Quarter

1st. Report MAY 20 1953

Completion

Remarks Barnett Drlg. - Contr.

Spudding Date 5-17-53

Drlg. Data

8" @ 104

FORM 26 200 BKS. 4-52 PETROL

Map No. _____ Sec. 21 Twp. 18 R. 1W


Well No. 1 State "B"

Glickman Oil Company

CORRECTION Contractor

SE SE NE

SECTION PLAT

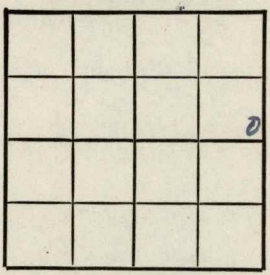

_____ Ft. from N. Line

330 Ft. from S. Line

330 Ft. from E. Line

_____ Ft. from W. Line

McPherson County

Location

Rig up

Drilling and Remarks:

Reported
#1 State "A"

RECORD

Cased _____ in., _____ ft.

Sand

Gas

Oil

Total Depth

PRODUCTION

1st 24 hrs. Nat.

1st 24 hrs. after shot

Gas _____ Cu. Ft.

Dry Hole

Abandoned

Date

JUN 10 1953

19

J. G. McGEHEE Scout

FORM 275 FOR SALE BY KANSAS BLUE PRINT CO.

County McPherson State Kansas

Sec. 21 (Blk. / Twp.) 18 (Sur. / Rge.) 1W Map No.

Operator Glickman Oil

Well No. 1 Farm State "B"

Elev. 1416 Location SE SE NE



330 Ft. From S Line NE

330 Ft. From E Line Quarter

1st. Report

Completion JUN ? 4 1953

Remarks

Barnett Drlg. - Contr.

Spudding Date 5-17-53

Drlg. Data Oil well TD 2752

8" @ 104 Heeb. 1938 Br. lime 2108

Lans. 2159 Chat 2742 DST 2742-48

open ½ hr. Rec. 30' mud 430#

5" @ 2743 TD 2752 CO to 2752

B/ 10 goph 500 A S/ 2¼ bo ¼ bwph

Comp. 30 bopd

J. G. McGEHEE