


Section 9 Township 20 Range 15W

Well No. 1 Schultz

Company Alkay Oil

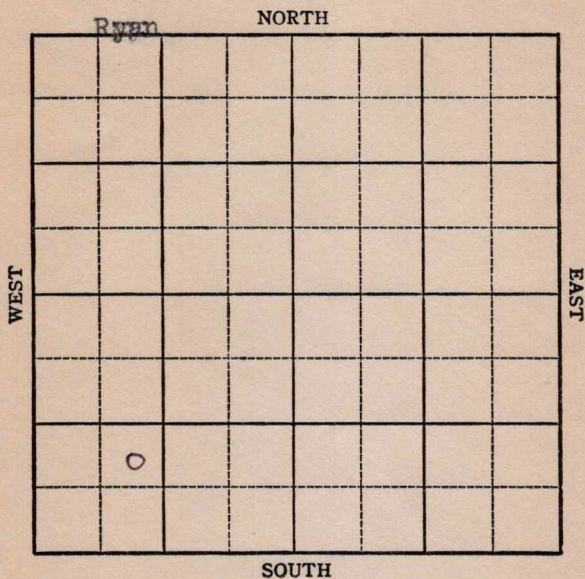

KANSAS

Barton

Sec. 9 Twp. 20 R. 15-W

Well No. 1 Schultz Farm

Alkay Oil

Company

Ryan Pool


Ft. from N. Line

990 Ft. from S. Line

Ft. from E. Line

990 Ft. from W. Line

NE SW SW

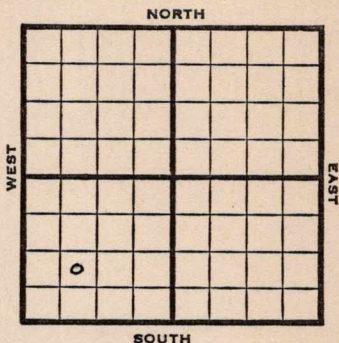

1947

Elev. 2048' REPORT

9/3 Anhy 1055'
Drlg. 2157'

9/10 Lansing 3458'
Drlg. 3609'

9/17 Cong. 3725'
Total Depth 3865 in Cong.

ABANDONED

Map No. _____ Sec. 9 Twp. 20 R. 15W

Well No. 1 Schultz

Alkay Oil Company

FIRST REPORT Contractor

NE SW SW


SECTION PLAT

_____ Ft. from N. Line

990 Ft. from S. Line

_____ Ft. from E. Line

990 Ft. from W. Line

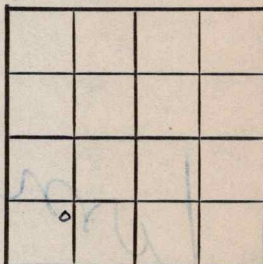

Barton County

Location _____

Rig up _____

Drilling and Remarks:

Anhy 1055

drlg. 2157

RECORD

Cased _____ in., _____ ft.

Sand _____

Gas _____

Oil _____

Total Depth _____

PRODUCTION

1st 24 hrs. Nat. _____

1st 24 hrs. after shot _____

Gas _____ Cu. Ft.

Dry Hole _____

Abandoned _____

Date

SEP 3 1947 19

S. J. LEWIS Scout

