

KANSAS


Barton

Section 8 Township 20 Range 15W

Well No. 1 Dechart "D"

Company Amerada et al

Pawnee Rock
NORTH

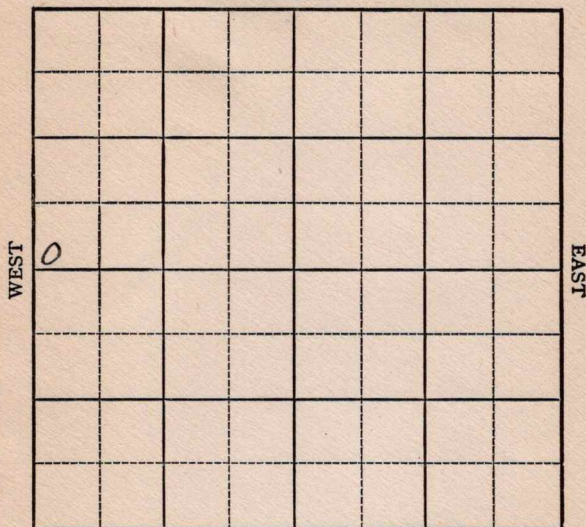

SOUTH

KANSAS

Barton

Sec. 8 Twp. 20 R. 15W ☒

Well No. #1 Deckert "D" Farm

Amerada et al Company

Pawnee Rock

 Ft. from N. Line

330'


 Ft. from S. Line

 Ft. from E. Line

330'

 Ft. from W. Line

SW NW

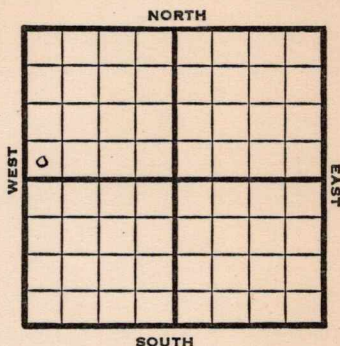

1949

Elev 2042'

R E P O R T

2/9

Location

2/16

8" @ 361'

Drlg. 2205'

2/23

Drlg 3674'

3/2

Arbuckle 3704'

TD 3790'

Run csg.

3/8

5"@ 3790'

3/16

"

3/23

TD 3790'

Arb. 3704'

5"@ 3790'

Perf 500 acid

Flow 160 Oil / 2% W Pot

364 Gr.

Comp

COMPLETED

Kansas

Pawnee Rock

Map No. _____ Sec. 8 Twp. 20 R. 15 WWell No. 1 Deebert "D"Amerada Etal Company

FIRST REPORT

Contractor

SW NW

SECTION PLAT

_____ Ft. from N. Line

330 Ft. from S. Line

_____ Ft. from E. Line

330 Ft. from W. LineBartonLocation ✓

Rig up _____

Drilling and Remarks:

RECORD

Cased _____ in., _____ ft.

Sand _____

Gas _____

Oil _____

Total Depth _____

PRODUCTION

1st 24 hrs. Nat. _____

1st 24 hrs. after shot _____

Gas _____ Cu. Ft.

Dry Hole _____

Abandoned _____

Date

FEB 9 1949

19

S. J. LEWIS

Scout

Kansas


Map No. 82 Sec. 8 Twp. 20 R. 15WWell No. 1 Deckert "D"Amerada etal.

Company

COMPLETE

Contractor

SW NW

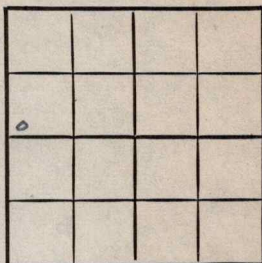E 12042
SECTION PLAT Ft. from N. Line330 Ft. from S. Line Ft. from E. Line330 Ft. from W. LineBarton County**RECORD**Location Cased in., ft.Rig up Sand

Drilling and Remarks:

Gas Oil Total Depth 8780**PRODUCTION**1st 24 hrs. Nat. 1st 24 hrs. after shot Gas Cu. Ft.Dry Hole Abandoned

Date

MAR 23 1949

19

S. J. LEWIS

Scout