

KANSAS

Barton

FORM 51 5M 4-41 PETROL

Section 9 Township 20 Range 15-W

Well No. 1 unruh

Company Central Petroleum et al

NORTH Wildcat


SOUTH

WEST EAST

(Wildcat)

Ft. from W. Line

Elev. 1999

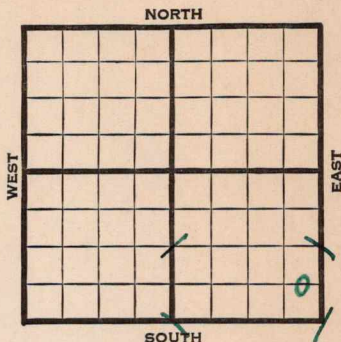

1941	REPORT
10/1	Location
10/9	"
10/16	Water well & tools.
10/23	" " " "
10/30	8" - 624' Drlg. 1811'
11/6	Anhy 995' Topeka 3077' Drlg. 3090'
11/12	Lans. 3414' Cong. 3688' Arb. 3726' T.D. 3798' No shows.
	ABANDONED

KANSAS


Map No. H-82 Sec. 9 Twp. 20 R. 15WWell No. 1 UnruhCentral Petroleum etal Company

Contractor

FIRST REPORT

C EL SE SE

SECTION PLAT

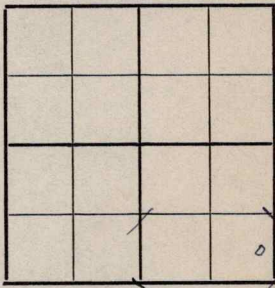 Ft. from N. Line660 Ft. from S. Line330 Ft. from E. Line Ft. from W. Line

WILDCAT

Location Rig up

Drilling and Remarks:

RECORD

Cased in., ft.Sand Gas Oil Total Depth

PRODUCTION

1st 24 hrs. Nat. 1st 24 hrs. after shot Gas Cu. Ft.Dry Hole Abandoned

Date

OCT 1 1941 19S. J. LEWIS Scout

Map No. K-82 Sec. 9 Twp. 20 R. 15WWell No. 1 UnruhCentral Petroleum etal CompanyABANDONED Contractor

C E L S E S E

SECTION PLAT

			0

 Ft. from N. Line660 Ft. from S. Line330 Ft. from E. Line Ft. from W. Line

WILDCAT

Location Rig up

Drilling and Remarks:

Wane 8414
Comp 8688
Per 3726
No show

RECORD

Cased in., ft.Sand Gas Oil Total Depth 378

PRODUCTION

1st 24 hrs. Nat. 1st 24 hrs. after shot Gas Cu. Ft.Dry Hole Abandoned

Date

NOV 12 1941

19

S. J. LEWIS Scout