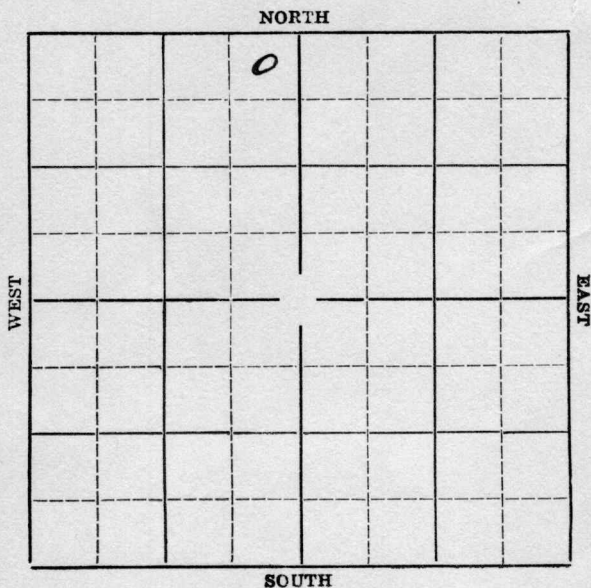


Section 20 Township 24 Range 13-EWell Number #1 CoffmanCompany Houstman Okla. Oil

Map No. KANSAS Sec. 20 Twp. 24 R. 13E

Well No. #1 Coffman Farm


Hanstman Okla. Oil Company

3300 Ft. from N. Line

 Ft. from S. Line

330' Ft. from E. Line

 Ft. from W. Line

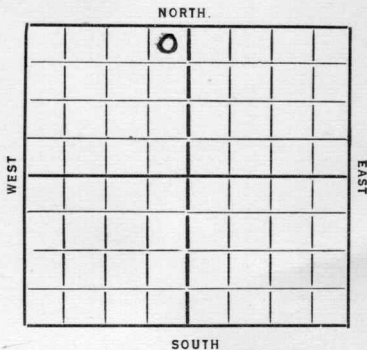

1936

REPORT

7/15 Drlg. 1075'.

7/23 Shut down.

7/29/36-T.D. 1638'.

Dry and abandoned.

ABANDONED

Greenwood

Form 26—1M Bks.—2-29

Map No. 17 Sec. 20 Twp. 24 R. 13

Well No. 1 Coffman

Houstonian Oil Co. Company

Contractor

SECTION PLAT

	0		

330 Ft. from N. Line

_____ Ft. from S. Line

330 Ft. from E. Line

_____ Ft. from W. Line

FIRST REPORT

Location _____

Rig up _____

Drilling and Remarks:

Log 1075

RECORD

Cased _____ in., _____ ft.

Sand _____

Gas _____

Oil _____

Total Depth _____

PRODUCTION

1st 24 hrs. Nat. _____

1st 24 hrs. after shot _____

Gas _____ Cu. Ft.

Dry Hole _____

Abandoned _____

Date

JUL 15 1936

19

S. J. LEWIS

Scout

KANSAS

Map No. _____ Sec. 20 Twp. 24 R. 13EWell No. 1 CoffmanHouston Oil & Gas Co. Company

Contractor _____

SECTION PLAT

330 Ft. from N. Line

_____ Ft. from S. Line

330 Ft. from E. Line

_____ Ft. from W. Line

CORRECTION

Location _____

Rig up _____

Drilling and Remarks:

Refracted
in ChocksonAbd 1638

RECORD

Cased _____ in., _____ ft.

Sand _____

Gas _____

Oil _____

Total Depth _____

PRODUCTION

1st 24 hrs. Nat. _____

1st 24 hrs. after shot _____

Gas _____ Cu. Ft.

Dry Hole _____

Abandoned _____

Date

JUL 29 1936 19

S. J. LEWIS Scout

KANSAS

Map No. 13 Sec. 20 Twp. 24 R. 13EWell No. 1 CoffmanHouston - Okla Oil Company

Contractor

SECTION PLAT

	0		

330 Ft. from N. Line

_____ Ft. from S. Line

330 Ft. from E. Line

_____ Ft. from W. Line

ABANDONED

Location _____

Rig up _____

Drilling and Remarks:

DTA

RECORD

Cased _____ in., _____ ft.

Sand _____

Gas _____

Oil _____

Total Depth 1638

PRODUCTION

1st 24 hrs. Nat. _____

1st 24 hrs. after shot _____

Gas _____ Cu. Ft.

Dry Hole _____

Abandoned _____

Date

JUL 29 1936

S. J. LEWIS Scout