


Section 12 Township 20 Range 15W

Well No. #1 Schultz

Company Kansas-Nebraska

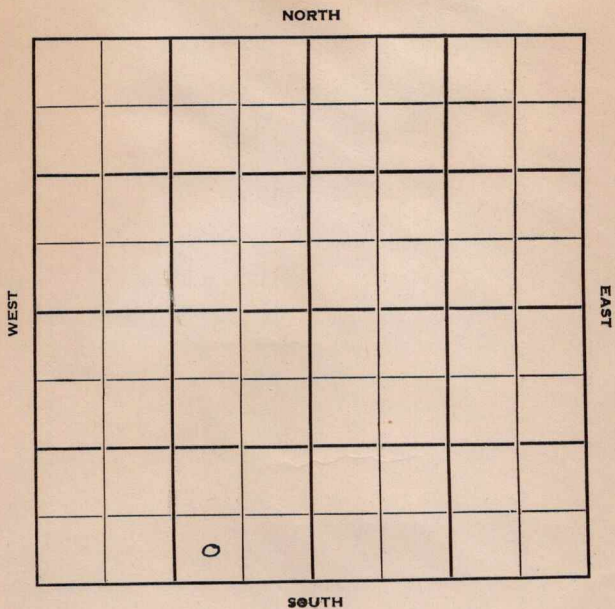

Barton

KANSAS

Sec. 12 Twp. 20 R. 15W ✓

Well No. #1 Schultz Farm

Kansas-Nebraska Company

Unruh Pool


Ft. from N. Line

330' Ft. from S. Line

990' Ft. from E. Line

Ft. from W. Line

SW SE SW

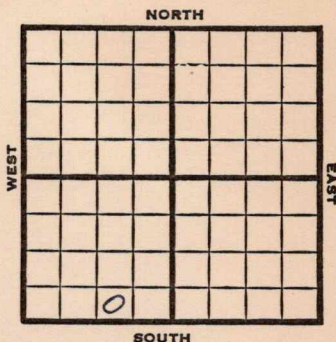

1951

Elev. 1956'

REPORT

8/29

Drlg.

9/5

Spud 8-15-51

D&A TD 3725

8" @ 939

Anhy 926 Heeb. 3233

Br Lime 3324 KC 3336

Cong. 3593 Arb. 3672

TD 3725

D&A

ABANDONED

J. E. TYRA

J. E. TYRA