


Section 22 Township 18 Range 1W
Well No. #2 Fortner
Company Glickman Oil

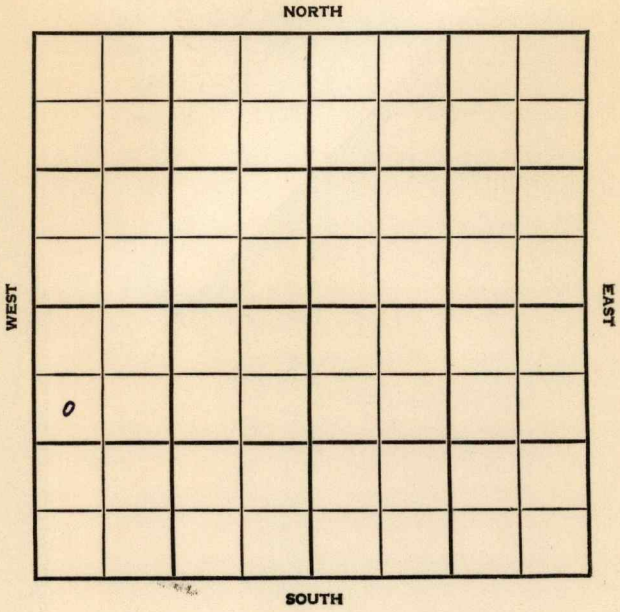

McPherson

KANSAS

SEC.	TWP.	R.
22	18	1 W

WELL NO.

2 Fortner

FARM

COMPANY

Glickman Oil

CONTRACTOR

Melland

S. Paden Pool


990 Ft. from N. Line

Ft. from S. Line

Ft. from E. Line

330 Ft. from W. Line

SW NW SW

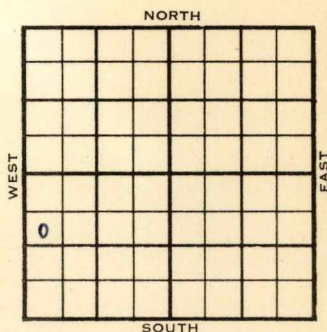

1954

ELEVATION

1443'

REPORT

12/15

Location

1955

1/19

Spud 12-18-54

Oil Well

TD 2814'

8" @ 153

Miss 2781'

DST 2782'-87' opn 1 hr, rec 15' Mud

DST 2792'-2808' opn 1 hr, rec 115' ho
& gcm 440 #

TD 2811'

5" @ 2808'

DD 2814'

S/ 3 bfph 50% oil FU 540' oil
460 wtr. 12 hr.

Comp 20 bopd. 20 bw.

COMPLETED

County McPherson State Kansas
 Sec. 22 (Blk. 18) (Sur. 1W) (Twp. 18) (Rge. 1W) Map No.
 Operator Glickman Oil
 Well No. 2 Farm Fortner
 Elev. 1443 Location SW NW SW

990Ft. From N Line SW
330Ft. From W Line Quarter
 1st. Report
 Completion JAN 1 9 1955
 Remarks S. Paden Pool
Melland - Contr.
 Spudding Date 12-18-54

Drlg. Data Oil well TD 2814
8" @ 153 Miss. 2781 DST 2782-87
open 1 hr. Rec. 15' mud DST 2792-2808
open 1 hr. Rec. 115' ho & gcm 440#
TD 2811 5" @ 2808 DD 2814 S/ 3 b fph
50% oil FU 540' oil 460' wtr. 12 hr.
Comp. 20 bopd 20 bw

FABEN GILSTRAP