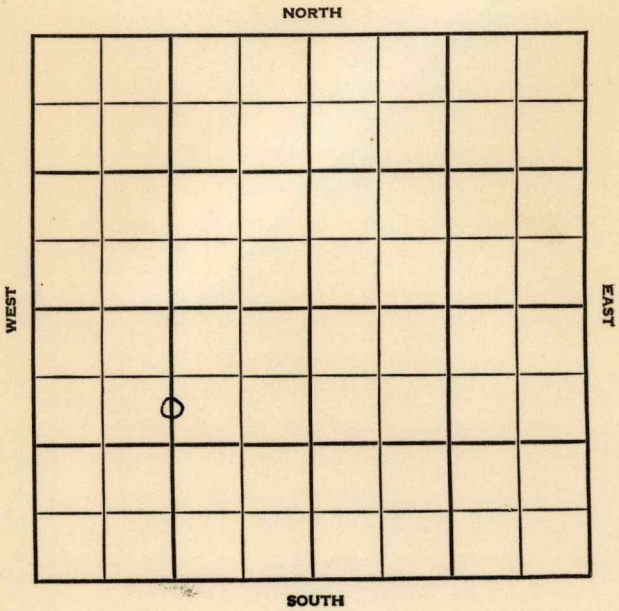


Section 22 Township 18 Range ~~1~~ WWell No. #3 FortnerCompany Glickman Oil

McPherson

KANSAS

SEC.	22	TWP.	18	R.	4W / W
------	----	------	----	----	-------------------

WELL NO.

#3 Fortner

FARM

COMPANY

Glickman Oil

CONTRACTOR

Melland

Maxwell

990


Ft. from N. Line

Ft. from S. Line

1320

Ft. from E. Line

Ft. from W. Line

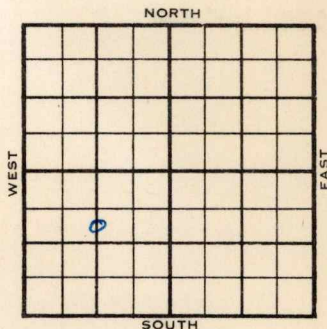C S $\frac{1}{2}$ ~~A~~ $\frac{1}{2}$ SW

1955

ELEVATION

1461'

REPORT

8/24

1/2 RUR

9-14

Comm 8-22-55

5 $\frac{1}{2}$ " @ 2825

DD 2830

B/ 15 goph

1000A

S/ 3/4 bo 7 bwph

Comp. 15 boyd 75 bw

Tops: L. 2208, M. 2794

T.D. 2829'

COMPLETED

SCOUT TICKET

DX-201

SEC.

22

TWP.

18

R.

1W

WELL NO.

3 Fortner

FARM

COMPANY

Glickman Oil

CONTRACTOR

CORRECTION


C S $\frac{1}{2}$ N $\frac{1}{2}$ SW

990 FT. FROM N. LINE

FT. FROM S. LINE

1320 FT. FORM E. LINE

FT. FROM W. LINE

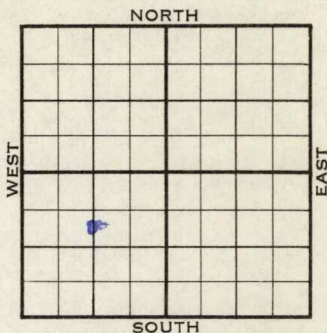

McPherson County

☐ LOCATION☐ RIG UP

DRILLING AND REMARKS:

Reported

22-18-4W

RECORD

CASED IN., FT.

SAND

GAS

OIL

TOTAL DEPTH

PRODUCTION

1ST 24 HRS. NAT.

1ST 24 HRS. AFTER SHOT

GAS CU. FT.

DRY HOLE

ABANDONED

DATE AUG 31 1955

SCOUT

T.J. Harris

Use.

No.

R U R

Sec.

下

五

County McPherson Elev. 1461
 Sec. 22 Twp. 18 Rge. 1W
 Company Glickman Oil
 Farm Name Fortner No. 3

TOPS	DEPTH	LOG	DATUM	Loc. in Sec.
Anh.				C S $\frac{1}{2}$ N $\frac{1}{2}$ SW
Tr.				
H.				
Tr.				
Dg.				
Bl.				
L.	2208		747	Geol.
K.C.				Contr.
B.K.C.				
Ce.				
C.				Melland
M.	2794		1333	Pool
M.				Maxwell
K.				
Mz.				
Ma.				
V.				
S.				
S.				
A.				
R.				
Pe.				
G.				
T.D.	2829			

COMPLETE

Date Comm. 8-22-55 SEP 14 1955
5 $\frac{1}{2}$ " @ 2825 DD 2830 B/ 15 goph
1000 A S/ 3/4 bo 7 bwph
Comp. 15 bopd 75 bw