
FORM 51

McPherson KANSAS

Section 22 Township 18 Range 1W

Well No. #1 Hodges "A"

Company Phillips Pet.

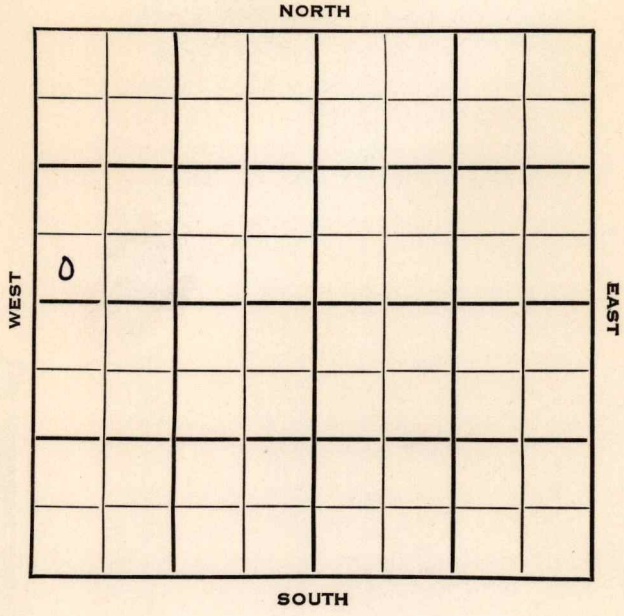

FORM 252-B

McPherson

KANSAS

Sec. 22 Twp. 18 R. 1W

Well No. #1 Hodges "A" Farm

Phillips Pet. Company

Sterling Drlg. Contractor

S. Paden Pool


____ Ft. from N. Line

330 Ft. from S. Line

____ Ft. from E. Line

330 Ft. from W. Line

SW SW NW

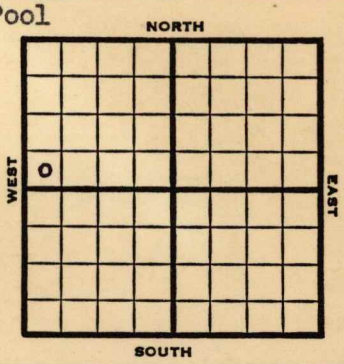

1953	Elev. 1414' REPORT
8/12	Location
8/19	8" @ 203 Drlg. 1650'
8/26	Heeb 1939' Tor 1970' Doug 1988' Br. li 2109' Lans 2169' B KC 2510' Marm 2522' Miss 2744' DST 2746-65, 1½ hrs, 17' VSOCM 60# DST 2766-75, 1½ hrs, 390' gas, 50' HOCM 350# RTD 2775' 5" @ 2769
9/2	CO Testing.
9/16	"
9/30	Spud 8-14-53 Oil well TD 2786 8" @ 203 Heeb 1939' Tor. 1970' Doug. 1988' Br lime 2109' Lans 2169' B KC 2510 Marm. 2522' Miss 2744 DST 2746-65 open 1½ hr rec 17' VSOCM 60# DST 2766-75 open 1½ hr rec 390' gas, 50' HOCM 350# TD 2775 5" @ 2769 DD 2776 B/6 GO 1¼ BW 4 hr. DD 2782 B/36½ GO 5 BW 5 hr. DD 2786 S/4 GO 1½ BW 1 hr. 8/2766-68 B/5-1/3 BO 11½ BW 9 hr. 20/2759-64 B/10½ BO 19 BW 16 hrs.

OVER

1953
9/30 (Information continued)
500 A S/20½ BO 62 BW 15 hr.
1500 A S/38¼ BO 138½ BW 10 hr.
PB 2779 S/3-2/3 BW 8 hr.
B/½ BO 5½ BW 9 hr. 300 A
S/4 BO 3 BW 7 hr. S/17-2/3 BO
35 BW 19 hr.
Comp. 37 BOPD 29 BW

COMPLETED

FORM 275 FOR SALE BY KANSAS BLUE PRINT CO.

County McPherson State Kansas

Sec. 22 (Blk. Twp.) 18 (Sur. Rge.) 1W Map No.

Operator Phillips Pet.

Well No. 1 Farm Hodges "A"

Elev. Location SW SWNW



330 Ft. From S Line NW

330 Ft. From W Line Quarter

1st. Report AUG 1 2 1953

Completion

Remarks Sterling Drlg. - Contr.

Spudding Date

Drlg. Data S. Paden Pool

Location

J. G. McGEHEE

FORM 275 FOR SALE BY KANSAS BLUE PRINT CO.


County McPherson State Kansas

Sec. 22 (Blk. Twp.) 18 (Sur. Rge.) 1W Map No.

Operator Phillips Pet.

Well No. 1 Farm Hodges "A"

Elev. 1414 Location SW SW NW

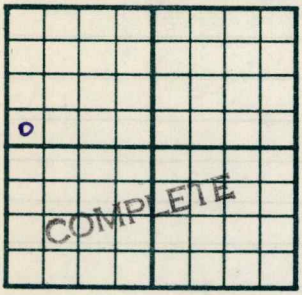

330 Ft. From S Line NW

330 Ft. From W Line Quarter

1st. Report

Completion SEP 30 1953

Remarks S. Paden Pool
Sterling Drlg. - Contr.

Spudding Date 8-14-53

Drlg. Data Oil well TD 2786

8" @ 203 Heeb. 1939 Tor. 1970

Doug. 1988 Br. lime 2109 Lans. 2169

B KC 2510 Marm. 2522 Miss. 2744

DST 2746-65 open 1½ hr. Rec. 17' vsocm

60# DST 2766-75 open 1½ hr. Rec. 390'

gas 50' hocm 350# TD 2775

5" @ 2769 DD 2776 B/ 6 go 1½ bw 4 hr.

DD 2782 B/ 36½ go 5 bw 5 hr. DD 2786

S/ 4 go 1½ bw 1 hr. 8/ 2766-68

B/ 5 1/3 bo 11½ bw 9 hr. 20/ 2759-64

B/ 10½ bo 19 bw 16 hr. 500 A

S/ 20½ bo 62 bw 15 hr. 1500 A

S/ 38¼ bo 138½ bw 10 hr. PB 2779

S/ 3 2/3 bw 8 hr. B/ ½ bo 5½ bw 9 hr.

J. G. McGEHEE

Drlg. Data

300 A S/ 4 bo 3 bw 7 hr.

S/ 17 2/3 bo 35 bw 19 hr.

Comp. 37 bopd 29 bw

