


Section 22 Township 18 Range 1W

Well No. 1 Serviss

Company Don Ingling

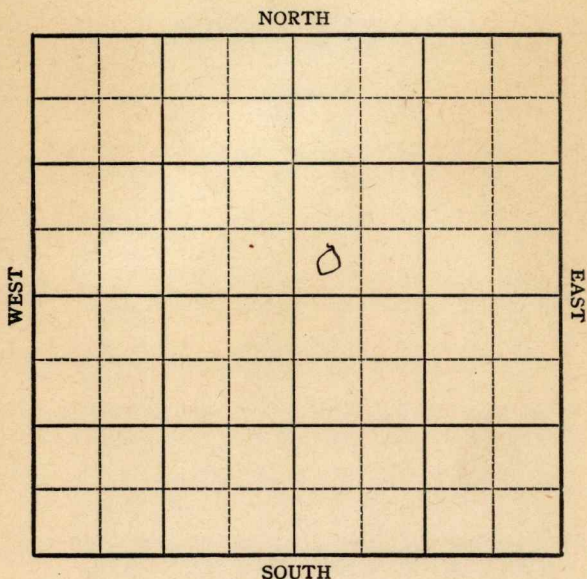

KANSAS

McPherson

Sec. 22 Twp. 18 R. 1W

Well No. #1 Service Farm
Don Ingling Company

Wildcat

 Ft. from N. Line

330'


 Ft. from S. Line

 Ft. from E. Line

330'

 Ft. from W. Line

SW NE

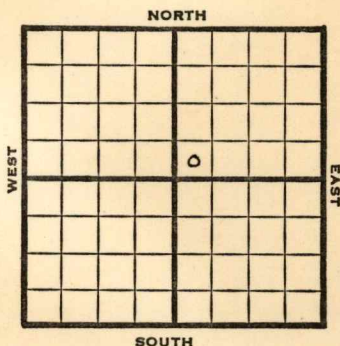

1948

Eli 1477'

R E P O R T

7/28

Location

8/4

8" @ 138'

Drlg. 1375'

8/11

Mississippi 2821'

Drlg 2840'

8/18

KC 2233'

Mississippi 2821'

Hunton 3223'

Viola 3326'

TD 3355'

Aband.

ABANDONED

McPherson County Kansas State

Map No. _____ Sec. 22 Twp. 18 R. 1W


Well No. 1 Serviss

Don Ingling Company

FIRST REPORT

SW NE Contractor

SECTION PLAT

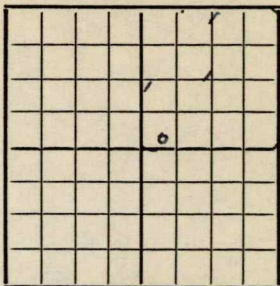

_____ Ft. from N. Line

330 Ft. from S. Line

_____ Ft. from E. Line

330 Ft. from W. Line

Wildcat

Remarks:

Location

Date JUL 28 1948

Scout S. J. LEWIS

McPherson County Kansas State

Map No. 42 Sec. 22 Twp. 18 R. 1W

Well No. 1 Serviss

Don Ingling Company

ABANDONED

Contractor

SW NE

E 1/4 77
SECTION PLAT

_____ Ft. from N. Line

330 Ft. from S. Line

_____ Ft. from E. Line

330 Ft. from W. Line

Wildcat

Remarks:

KC 2223

Miss 2821

Hunt 3223

Vila 3326

TDJ 3305

Date

Scout

S. J. LEWIS

AUG 18 1948