

McPherson

KANSAS

SEC.

28

TWP.

18S

R.

1W

WELL NO.

1 Johnson

FARM

COMPANY

Mellard et al

CONTRACTOR


Wildcat

_____ Ft. from N. Line

_____ Ft. from S. Line

_____ Ft. from E. Line

_____ Ft. from W. Line

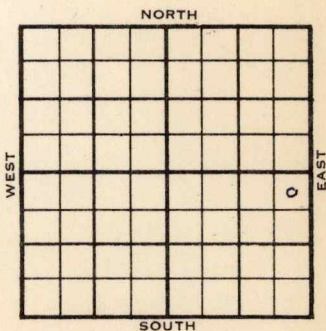

NE NE SE

1955

ELEVATION

1442'

REPORT

5/25

Miss 2796;

TD 2846; 8" 154; no log

D&A

FIRST REPORT

f

ABANDONED