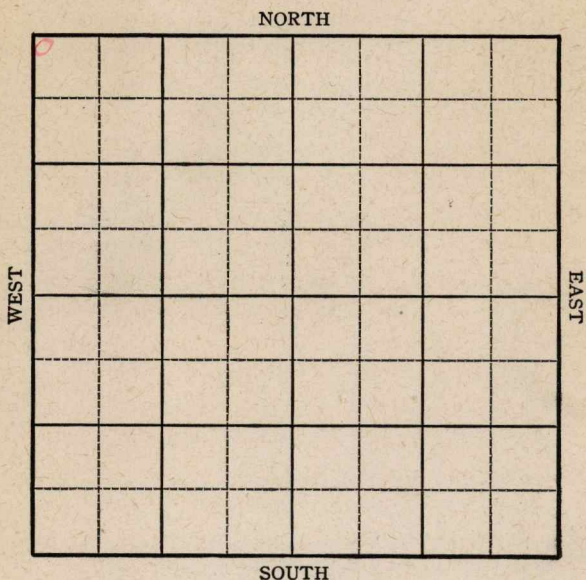


KANSAS

McPherson

Section 23 Township 18 Range 1WWell No. 1 Raussmussen "A"Company Sharon Drlg.

KANSAS

McPherson

Sec. 23 Twp. 18 R. 1-W

Well No. #1 Raussmussen "A" Farm

Sharon Drlg. Company


330 Ft. from N. Line

 Ft. from S. Line

 Ft. from E. Line

330 Ft. from W. Line

NW/c Elev. 1465

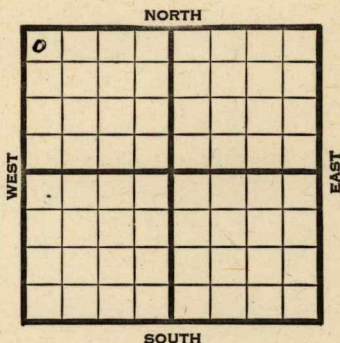

1945

REPORT

8/15	Location
8/22	"
8/29	"
9/5	8" @ 167 WOC
9/12	Drlg. 1975
9/19	Miss. 2784
	TD 2812
	5" @ 2795 RUST
9/26	TD 2823 10 0 acid.
	Swb. 9 fluid per hr. 5% oil
10/3	Miss. 2784
	5" @ 2795
	1000 acid.
	TD 2823'

ABANDONED

KANSAS

Kansas

Pool Name CrowtherMap No. 42 Sec. 23 Twp. 18 R. 1WWell No. 1 Raussmussen "A"

Sharon Drlg.

Company

FIRST REPORT

Contractor

NW/c

SECTION PLAT

0			

330 Ft. from N. Line

Ft. from S. Line

Ft. from E. Line

330 Ft. from W. Line

McPherson County

Location X

Rig up

Drilling and Remarks:

RECORD

Cased _____ in., _____ ft.

Sand _____

Gas _____

Oil _____

Total Depth _____

PRODUCTION

1st 24 hrs. Nat. _____

1st 24 hrs. after shot _____

Gas _____ Cu. Ft.

Dry Hole _____

Abandoned _____

Date

AUG 15 1945

19

S. J. LEWIS

Scout

KANSASPool Name Crowther
KansasMap No. 42 Sec. 23 Twp. 18 R. 1WWell No. 1 Raussmussen "A"

Sharon Drlg.

Company


ABANDONED

Contractor

NW/c

E. 1465
SECTION PLAT330 Ft. from N. Line Ft. from S. Line Ft. from E. Line330 Ft. from W. Line

McPherson

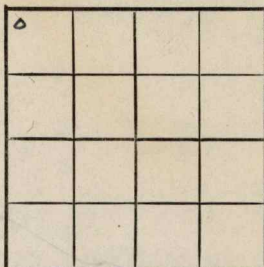Location Rig up

Drilling and Remarks:

Miss 2784
5 "C 2795
1000 acut

RECORD

Cased in., ft.Sand Gas Oil Total Depth 2823

PRODUCTION

1st 24 hrs. Nat. 1st 24 hrs. after shot Gas Cu. Ft.Dry Hole Abandoned

Date

OCT 3 1945 19

S. J. LEWIS

Scout