


Map No. Kansas Sec. 28 Twp. 24 R. 13

Well No. 1 Raghu Farm _____
Chas Cross Company _____

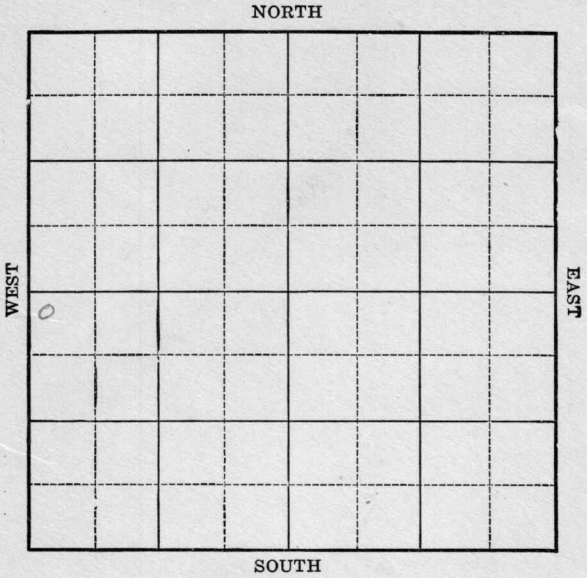

Location _____

Drilling Remarks _____

Rig Up _____

Drilling Remarks _____

RECORD

Cased _____ in. _____ ft.

Sand _____

Gas _____

Oil _____

Total Depth _____

PRODUCTION

1st 24 hrs. Nat. _____

1st. 24 hrs. after shot _____

Gas _____ cu. ft.

Dry Hole _____

Abandoned _____

Map No. Kane Sec. 28 Twp. 24 R. 13


Well No. #1 Roglin Farm
Chas Cross Company

200 Ft. from N. Line

_____ Ft. from S. Line

_____ Ft. from E. Line

200 Ft. from W. Line

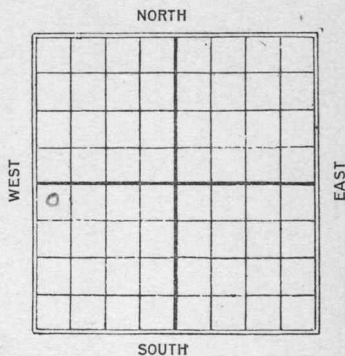

Date
1925

REPORT

2/8 Location

3/30 Abandoned 1642

Map No. no map Sec. 28 Twp. 24 R. 13

Well No. #1 Raglin

Chas Cross Company

Contractor

FIRST REPORT

SECTION PLAT

200 Ft. from N. Line

_____ Ft. from S. Line

_____ Ft. from E. Line

200 Ft. from W. Line

0			

Location ✓✓

Rig up _____

Drilling and Remarks:

RECORD

Cased _____ in., _____ ft.

Sand _____

Gas _____

Oil _____

Total Depth _____

PRODUCTION

1st 24 hrs. Nat. _____

1st 24 hrs. after shot _____

Gas _____ Cu. Ft.

Dry Hole _____

Abandoned _____

Date

2/8 1925

M. A. BENEAR

Scout

Map No. **KANSAS** Sec. **28** Twp. **24** R. **13**

Well No. **1 Raglin**
Chas Cross et al Company

Contractor

ABANDONED

SECTION PLAT

200' Ft. from N. Line

----- Ft. from S. Line

----- Ft. from E. Line

200' Ft. from W. Line

0			

Location -----

Rig up -----

Drilling and Remarks:

Tap L. 1605

RECORD

Cased ----- in., ----- ft.

Sand -----

Gas -----

Oil -----

Total Depth -----

PRODUCTION

1st 24 hrs. Nat. -----

1st 24 hrs. after shot -----

Gas ----- Cu. Ft.

Dry Hole -----

Abandoned **1642**

M. A. BENEAR

Date

3/30

1925

Scout