
FORM 51 25M 8-50 WESTERN McPherson KANSAS

Section 23 Township 18 Range 1W

Well No. #1 White

Company National Cooperative Refinery Assn.

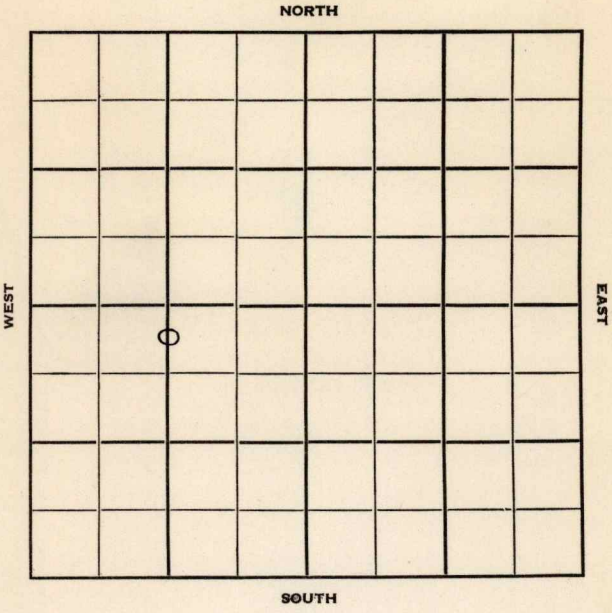

FORM 252-B
10M 10-50 PETROL

McPherson

KANSAS

Sec. 23 Twp. 18 R. 1 W

Well No. # 1 White Farm

National Cooperative Refinery Assn Company

Ingling Contractor

Wildcat


330 Ft. from N. Line

Ft. from S. Line

1320 Ft. from E. Line

Ft. from W. Line

C N/2 N/2 SW

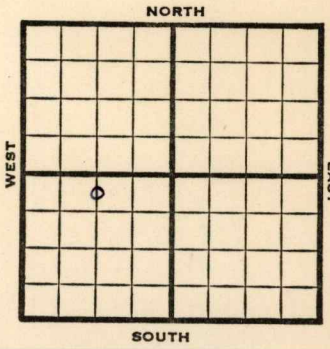

1951	Elev. 1461' REPORT
10/17	RUR
10/31	Spud 10-16-51 8" @ 126 Miss 2786' TD 2836' D & A ABANDONED

FORM 275 FOR SALE BY KANSAS BLUE PRINT CO.

County Mc Pherson State Kansas

Sec. 23 (Blk. Twp.) 18 (Sur. Rge.) 1W Map No.

Operator National Cooperative Refinery Assn.

Well No. 1 Farm White

Elev. Location C N/2 N/2 SW



330 Ft. From N Line SW

1320 Ft. From E Line Quarter

1st. Report OCT 17 1951

Completion

Remarks Ingling - Contr.

Spudding Date

Drlg. Data Wildcat

RUR

J. E. TYRA

FORM 275 FOR SALE BY KANSAS BLUE PRINT CO.


County McPherson State Kansas

Sec. 23 (Blk. Twp.) 18 (Sur. Rge.) 1W Map No.

Operator National Cooperative Refinery Assn.

Well No. 1 Farm White

Elev. 1461 Location C N L N½ SW

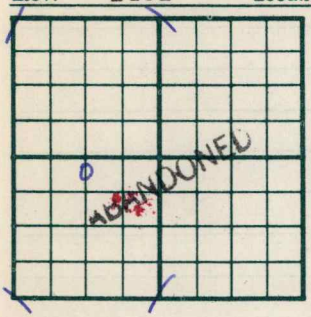

330 Ft. From N Line SW

1320 Ft. From E Line Quarter

1st. Report

Completion OCT 31 1951

Remarks

Ingling - Contr.

Spudding Date 10-16-51

Drlg. Data

8" @ 126 Miss. 2786 TD 2836

D & A

J. E. TYRA