
McPherson KANSAS

SECTION 24 TOWNSHIP 18S RANGE 1W

WELL NO. #1 Crowther

COMPANY Boge & Gould

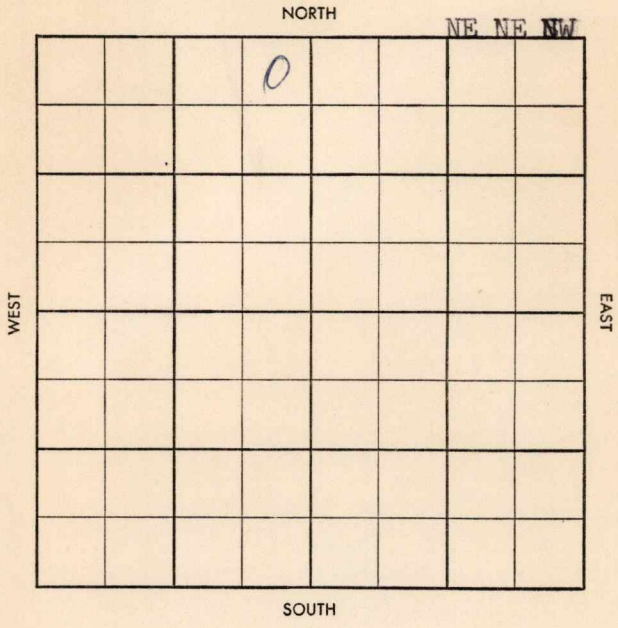

S-513-B

County McPherson Elev.

Sec. 24 Twp. 18 Rge. 1W

Company Boge & Gould

Farm Name Crowther No. 1


TOPS	DEPTH	LOG	DATUM
Anh.			
Tp.			
H.			
Tr.			
Dg.			
B. L.			
L.			
K.C.			
B.K.C.			
Ce.			
C.			
M.			
M.			
K.			
Mz.			
Mq.			
V.			
S.			
S.			
A.			
R.			
Pf.			
G.			
T.D.			

Loc. in Sec. NE NE NW

Geol.

Contr. See-Ro-Bee

Pool Battle Hill

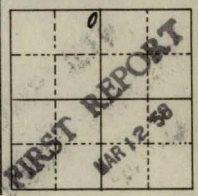

Date Comm. 3-7-58

drlg.

Co. Lse. No. Sec. T. R.

Twp. X Pool X

Co. X Facet X

S-513-B

County McPherson Elev. 1504 KB

Sec. 21 Twp. 18 Rge. 1W

Company Poge & Gould (Charlie)

Farm Name Crowther No. 1

TOPS	DEPTH	LOG	DATUM
Anh.			
Tp.			
H.			
Tr.			
Dg.			
B. L.			
L.	2234		
K.C.			
B.K.C.			
Ce.			
C.			
M.	2819		
M.			
K.			
Mz.			
Mq.			
V.			
S.			
S.			
A.			
R.			
Pf.			
G.			
T.D.	2925		

Loc. in Sec. NE NE NW

Geol. Pat Simmons

Contr. See-Ro-Bee

Pool Battle Hill

APR 23 '58

ABANDONED

Date Comm. 3-7-58

drlg. MAR 19 '58 8" 210/175 Tops of 2920 - 25 [redacted] of 60" 30' M with 550 BHP 590/20" TD 5½" 2920 WOCT MAR 26 '58 APR 2 '58 APR 9 '58 CO APR 16 '58 APR 23 '58 CO DD 2842 TD & 5 BWph VSSO NT FV 1440 W 12hrs

D&A

Co. Lse. No. Sec. T. R.