

KANSAS

FORM 51 5M 10-41 PETROL


McPherson

Section 25 Township 18 Range 1-W

Well No. #1 Cunningham

Company Winkler-Koch

Canton pool

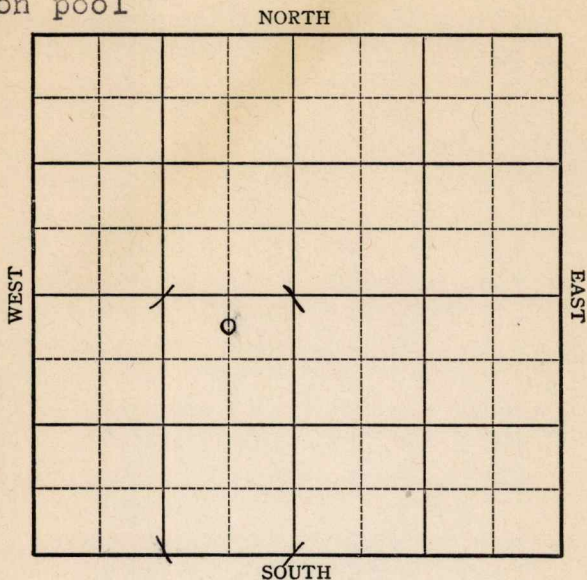

KANSAS

McPherson

Sec. 25 Twp. 18 R. 1-W

Well No. #1 Cunningham Farm

Winkler-Koch Company

Canton Pool


330 Ft. from N. Line

 Ft. from S. Line

660 Ft. from E. Line

 Ft. from W. Line

C NL NE SW

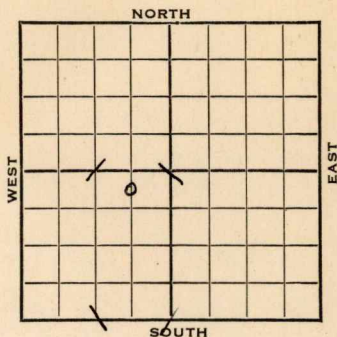

1942

REPORT

12/2

10" - 154'

Drlg. 955'

12/9

Drlg. 2706

12/16

Miss 2824

Based SD 3537

Sat 3544 TD

5" @ 3539 Rust.

12/22

" " "

12/29

TD 2833 - no shows.

1943

1/6

Miss. 2824

7" - 2825

5 qts. 2833-38 - water

TD 2857


ABANDONED

McPherson

KANSASMap No. 42 Sec. 25 Twp. 18 R. 1WWell No. 1 CunninghamWinkler-Koch CompanyABANDONED Contractor

C NL NE SW

SECTION PLAT

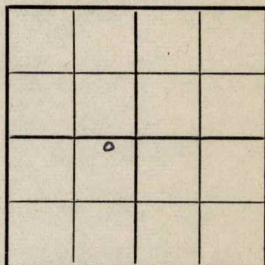330 Ft. from N. Line Ft. from S. Line660 Ft. from E. Line Ft. from W. Line

CANTON POOL

Location Rig up

Drilling and Remarks:

Miss 2824
2" @ 2825.
59 to 2833-38.
Water.

RECORD

Cased in., ft.Sand Gas Oil Total Depth 2857

PRODUCTION

1st 24 hrs. Nat. 1st 24 hrs. after shot Gas Cu. Ft.Dry Hole Abandoned

Date

JAN 6 1943 19S. J. LEWIS Scout


KANSAS

Map No. 42 Sec. 25 Twp. 18 R. 1WWell No. 1 CunninghamWinkler-Koch CompanyFIRST REPORT Contractor

C NL NE SW

330 Ft. from N. Line Ft. from S. Line660 Ft. from E. Line Ft. from W. Line

SECTION PLAT

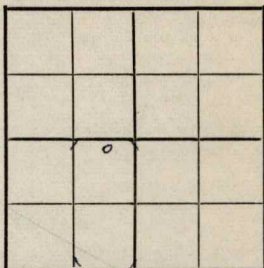

CANTON POOL

Location Rig up

Drilling and Remarks:

10"-154'Drlg. 955'

RECORD

Cased in., ft.Sand Gas Oil Total Depth

PRODUCTION

1st 24 hrs. Nat. 1st 24 hrs. after shot Gas Cu. Ft.Dry Hole Abandoned

Date

DEC 2 1942 19S. J. LEWIS Scout