

Greenwood


Form 51-5M-11-31-Palace

Map No. KANSAS Sec. 30 Twp. 24 R. 13E

Well No. 1-Flunginsmith Farm

Goodwin & Co. Company

NORTH

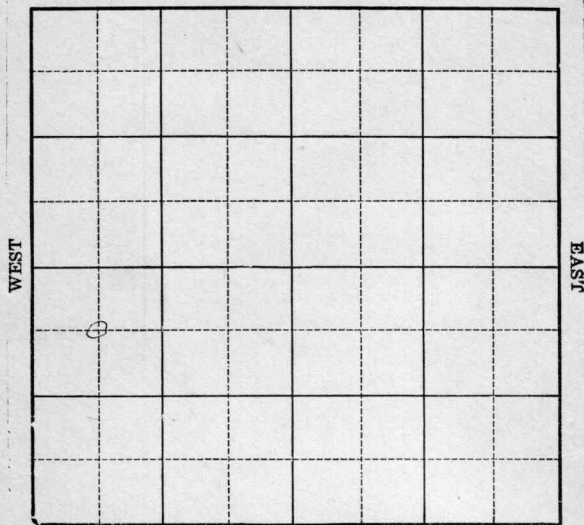

SOUTH

Location

Drilling Remarks

Rig Up

Drilling Remarks

RECORD

Cased in. ft.

Sand

Gas

Oil

Total Depth

PRODUCTION

1st 24 hrs. Nat.

1st 24 hrs. after shot

Gas cu. ft.

Dry Hole

Abandoned


Greenwood

Map No. KANSAS Sec. 30 Twp. 24 R. 13^E

Well No. 1-Klingensmith Farm

Goodwin & Co. Company

NORTH

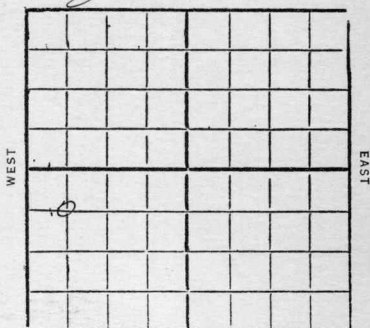

660 Ft. from N. Line

_____ Ft. from S. Line

_____ Ft. from E. Line

660 Ft. from W. Line

1932

Date

REPORT

8/3	<i>Ady.</i>
8/10	<i>Ady.</i>
8/17	8"-940 Dreg 955'
8/24	" 1200'
8/31	SD 1200'
9/7	Top line 1690 TD 1722' HFW Abandoned
1932	OWDID
10/12	Ced TD 1722' VIR 6" to deepen
10/19	
10/26	Top line 1690 SD 1755'
11/2	
11/9	Top line 1690 TD 1822 dry & Abandon

Greenwood

17 KANSAS E
 Map No. Sec. 30 Twp. 24 R. 13
 Well No. 1 Kling in Smith
 Goodwin & Egan Company
 Contractor

FIRST REPORTS

660 Ft. from N. Line

Ft. from S. Line

Ft. from E. Line

660 Ft. from W. Line

SECTION PLAT

Location

Rig up

Drilling and Remarks:

Open

RECORD

Cased in., ft.

Sand

Gas

Oil

Total Depth

PRODUCTION

1st 24 hrs. Nat.

1st 24 hrs. after shot

Gas Cu. Ft.

Dry Hole

Abandoned

Date

AUG 3 1932

CHAS. L. SHERWOOD

192

Scout

Greenwood

E

17 KANSAS

Map No. Sec. 30 Twp. 24 R. 13

Well No. 1 Klingin Smith

Goodwin & Egan Company

Contractor

COMPLETED

SECTION PLAT

0			

660 Ft. from N. Line

Ft. from S. Line

Ft. from E. Line

660 Ft. from W. Line

ABANDONED

Location

Rig up

Drilling and Remarks:

Top Line 1690

HRW 1722

RECORD

Cased in., ft.

Sand

Gas

Oil

Total Depth 1722

PRODUCTION

1st 24 hrs. Nat.

1st 24 hrs. after shot

Gas Cu. Ft.

Dry Hole ✓

Abandoned ✓

Date

SEP 7 1932

CHAS. L. SHERWOOD

192 Scout

17 KANSAS Map No. Sec. 30 Twp. 24 R. 13

Well No. 1 Kling in Smith
Goodwin & Egan Company
Contractor

FIRST REPORTS

660 Ft. from N. Line
Ft. from S. Line
Ft. from E. Line
660 Ft. from W. Line

SECTION PLAT

	"O.W.D."		

Location.....

Rig up.....

Drilling and Remarks:

Top Line 1690

O.D. T.D. 1722

1/R 6" to

Deepen

RECORD

Cased.....in.,ft.

Sand.....

Gas.....

Oil.....

Total Depth.....

PRODUCTION

1st 24 hrs. Nat.....

1st 24 hrs. after shot.....

Gas.....Cu. Ft.

Dry Hole.....

Abandoned.....

Date

OCT 12 1932 CHAS. L. SHERWOOD

192.....

Scout

Greenwood

E

17 KANSAS Map No. Sec. 30 Twp. 24 R. 13

Well No. 1 Klinginsmith
Goodwin & Egan Company

Contractor

COMPLETED


SECTION PLAT

660 Ft. from N. Line

Ft. from S. Line

Ft. from E. Line

660 Ft. from W. Line

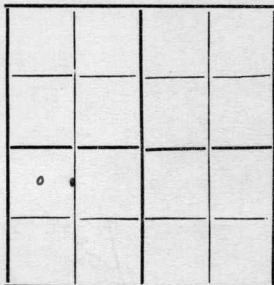

ABANDONED

Location

Rig up

Drilling and Remarks:

Tap Line 1690

RECORD

Cased in., ft.

Sand

Gas

Oil

Total Depth 1822

PRODUCTION

1st 24 hrs. Nat.

1st 24 hrs. after shot

Gas Cu. Ft.

Dry Hole ✓

Abandoned ✓

Date

NOV 9 1932 CHAS. L. SHERWOOD Scout