


Map No. KANSAS Sec. 26 Twp. 18 R. 1-W
Well No. #1 Cunningham Farm
Empire Oil and Gas Company

NORTH

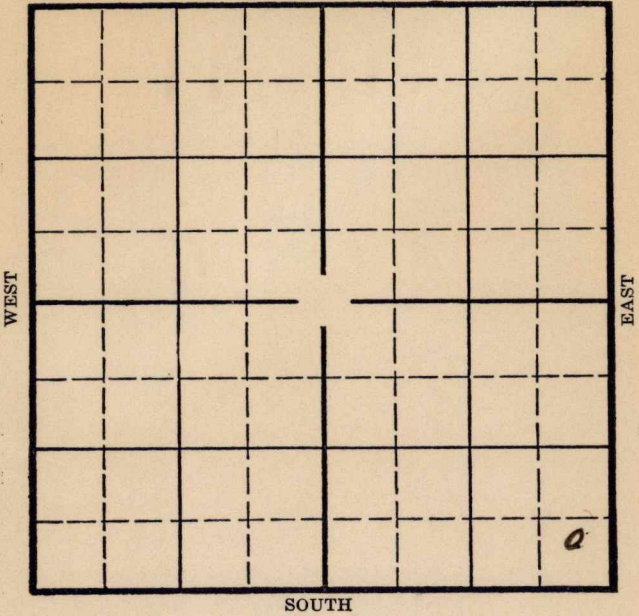

Location-----
Drilling Remarks

Rig Up-----
Drilling Remarks

RECORD

Cased _____ in. _____ ft.

Sand _____

Gas _____

Oil _____

Total Depth _____

PRODUCTION

1st 24 hrs. Nat. _____

1st 24 hrs. after shot _____

Gas _____ cu. ft. _____

Dry Hole _____

Abandoned _____

7/22/36-Chat 2803'.

T.D. 2832'.

3000 gallons of acid.

Flow 831 bbls of oil. Potential.

COMPLETED

Map No. 42 Sec. 26 Twp. 18 R. 14Well No. 1 CanninghamEmpire Oil & Gas Company

Contractor

SECTION PLAT

Ft. from N. Line

430 Ft. from S. Line320 Ft. from E. Line

Ft. from W. Line

FIRST REPORTS

			3

Location

Rig up

Drilling and Remarks:

Moving in

RECORD

Cased _____ in., _____ ft.

Sand _____

Gas _____

Oil _____

Total Depth _____

PRODUCTION

1st 24 hrs. Nat. _____

1st 24 hrs. after shot _____

Gas _____ Cu. Ft.

Dry Hole _____

Abandoned _____

Date

3/25/26 192

S. J. LEWIS Scout

KANSAS

Map No. 42 Sec. 26 Twp. 18 R. 14Well No. 1 CunninghamEmpire Company

Contractor

SECTION PLAT

			o

_____ Ft. from N. Line

430 Ft. from S. Line330 Ft. from E. Line

_____ Ft. from W. Line

COMPLETED

Location _____

Rig up _____

Drilling and Remarks:

Chas 28033000 acidFlow 831 Bt.

RECORD

Cased _____ in., _____ ft.

Sand _____

Gas _____

Oil _____

Total Depth 2832

PRODUCTION

1st 24 hrs. Nat. _____

1st 24 hrs. after shot _____

Gas _____ Cu. Ft.

Dry Hole _____

Abandoned _____

Date

JUL 22 1936

19

S. J. LEWIS

Scout