

SOUTH

McPherson

Sec. 26 **KANSAS** Twp. 18 R. 1-W

Well No. 2 Cunningham Farm

Cities Service

Company


No Name

990 Ft. from N. Line

~~990~~ Ft. from S. Line

990 Ft. from E. Line

_____ Ft. from W. Line

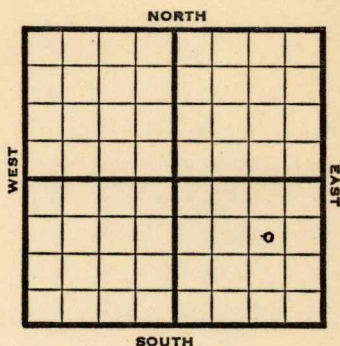

SW NE SE

1947 **Elev. 1525** REPORT

9/3 Surface Hole

9/10 8" @ 168'
Drlg. 2600'

9/17 **Mississippi 2831'**

TD 2840'

5" @ 2835'

Swab 5 bbls. oil / 13 W in 8 hrs.

9/24 Pump 10 bbls. oil / 57 W in 24 hrs.

10/1 **Miss. 2831**

5" @ 2835

Pump 10 oil & 57 wtr. 24 hrs.

TD 2840

Gravity 36

Map No. _____ Sec. 26 Twp. 18 R. 1W

Well No. 2 Cunningham

Cities Service

Company

FIRST REPORT

Contractor

SW NE SE

SECTION PLAT

			o

_____ Ft. from N. Line

990 Ft. from S. Line

890 Ft. from E. Line

_____ Ft. from W. Line

McPherson County

Location _____

Rig up _____

Drilling and Remarks:

surface hole

RECORD

Cased _____ in., _____ ft.

Sand _____

Gas _____

Oil _____

Total Depth _____

PRODUCTION

1st 24 hrs. Nat. _____

1st 24 hrs. after shot _____

Gas _____ Cu. Ft.

Dry Hole _____

Abandoned _____

Date

SEP 3 1947 19

S. J. LEWIS

Scout

Map No. 42 Sec. 26 Twp. 18 R. 1W

Well No. 2 Cunningham

Cities Service

Company

COMPLETE

Contractor

SW NE SE


E, 1525
SECTION PLAT

990 Ft. from N. Line

90 Ft. from S. Line

890 Ft. from E. Line

 Ft. from W. Line

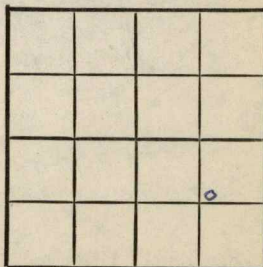

McPherson County

Location

Rig up

Drilling and Remarks:

Miss 2831
5" @ 2835
Pump. 10 oil +
57 W 24 W

36 cu

RECORD

Cased in., ft.

Sand

Gas

Oil

Total Depth 2840

PRODUCTION

1st 24 hrs. Nat.

1st 24 hrs. after shot

Gas Cu. Ft.

Dry Hole

Abandoned

Date

OCT 1 1947 19

S. J. LEWIS Scout

Check feet measurements and advise

Sam

Check ft. from ss. or no.

[Handwritten signature] 11/14

[Handwritten signature] 11/14

Misc. Small
Cards
Tracing
France Map
Scarborough
Pierce
Geological Dept.
Pierce

Map No. 42 Sec. 26 Twp. 28 R. 1W

Well No. 2 Cunningham

Cities Service

Company

CORRECTION

Contractor

SW NE SE

SECTION PLAT

990 Ft. from N. Line

 Ft. from S. Line

890 Ft. from E. Line

 Ft. from W. Line

			o

CORRECTION

McPherson County

Location

Rig up

Drilling and Remarks:

Reported

990 from S. line

RECORD

Cased in., ft.

Sand

Gas

Oil

Total Depth

PRODUCTION

1st 24 hrs. Nat.

1st 24 hrs. after shot

Gas Cu. Ft.

Dry Hole

Abandoned

Date

NOV 5 1947 19

S. J. LEWIS Scout

Pool Name NO NAMEMap No. 42 Sec. 26 Twp. 18 R. 1WWell No. 2 CUNNINGHAMCITIES SERVICE Company**COMPLETED**

Contractor

SW NE SE

SECTION PLAT

			0

990 Ft. from N. Line990 Ft. from S. Line890 Ft. from E. Line

Ft. from W. Line

CORRECTIONMcPherson County

Location _____

Rig up _____

Drilling and Remarks: _____

RECORD

Cased _____ in., _____ ft.

Sand _____

Gas _____

Oil _____

Total Depth _____

PRODUCTION

1st 24 hrs. Nat. _____

1st 24 hrs. after shot _____

Gas _____ Cu. Ft.

Dry Hole _____

Abandoned _____

Date _____