

McPherson

KANSAS

SECTION 28 TOWNSHIP 18 RANGE 1W

WELL NO. #1 Johnson

COMPANY Greenland Drlg

NORTH

0							

SOUTH

WEST EAST

McPherson

KANSAS

SEC.	TWP.	R.
28	18	1W

WELL NO.

#1 Johnson

FARM

COMPANY

Greenland Drlg.

CONTRACTOR

~~WILDCAT~~ Round Hill


Ft. from N. Line

Ft. from S. Line

Ft. from E. Line

Ft. from W. Line

SW SW SW

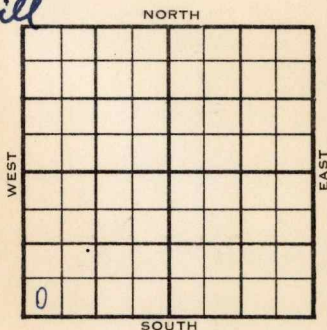

1956

ELEVATION

1482'

REPORT

4-18

Comm. 4-14-56
 8" @ 145 w/100
 Drlg. 1300

4-25

DST 2832-41, op 1 hr, 2500' GCO /
 30' wtr
 BHP 580/ 15"
 5 1/2" @ 2832 w/100

5-2

CO 2841; FU 2000 oil / 2 hrs.
 Putting on pump

5-9

No report

5-23

" "

5-29

" "

6-6

" "

6-13

P/ 92 bopd / wtr.

6-20

P/ 93 bopd, no/wtr.

Grav. 39°

L. 2252', Sd. 2831'.

TD 2841'

COMPLETED

CORRECTION

FORM 513 SUNRAY

County McPherson Elev. 1482
 Sec. 28 Twp. 18 Rge. 1W
 Company Greenland Drilling
 Farm Name Johnson No. 1

TOPS	DEPTH	LOG	DATUM	Loc. in Sec.
Anb.				SW SW SW
Tr.				
Dg.				
BL.				
L.	2252			
K.C.				Geol.
B.K.C.				Concr.
Ce. <u>sd</u>	2831			
C.				
M.				
M.				
K.				
Mz.				
Me.				
V.				
S.				
S.				
A.				
R.				
Pe.				
G.				
TD.	2841			

Round Hill
Pool

COMPLETE

Date Comm. 1-11-56 JUN 20 1956

8" @ 145/100 drl. 1300 APR 25 '56 DST

2832-41 1hr 2500' GCO + 30'

wtr 13HP 580/15 5 1/2 @ 2832

1100 MAY 2 '56 CO 2841 FU 2000'

oil 2 hrs. POP MAY 9 '56 ✓ MAY 16 '56

MAY 23 '56 MAY 29 '56 ✓ JUN 6 '56 JUN 13 '56

POP 92 BOPD + wtr JUN 20 '56

Ph P 93 BOPD no wtr

grav. 39°

County McPherson Elev. _____
 Sec. 28 Twp. 18 Rge. 1W
 Company Greenland Drlg.
 Farm Name Johnson No. 1

TOPS	DEPTH	LOG	DATUM	Loc. in Sec.
Anh.				SW SW SW
Tr.				
H.				
Tr.				
Dg.				
Bl.				
L.				Geol.
K.C.				Contr.
B.K.C.				
Ce.				
C.				
M.				Pool
M.				Wildcat
K.				
Mz.				
Me.				
V.				
S.				
S.				
A.				
R.				
Pe.				
G.				
T.D.				

FIRST REPORT
 APR 18 '56

Date Comm. 4-14-56
8" @ 145/100 d rlg. 1300

APR 18 1956

R.G.