


SECTION 28 TOWNSHIP 18 RANGE 1WWELL NO. #8 GreenwoodCOMPANY Greenland Drlg.

NORTH NE SE NW

WEST

EAST

SOUTH

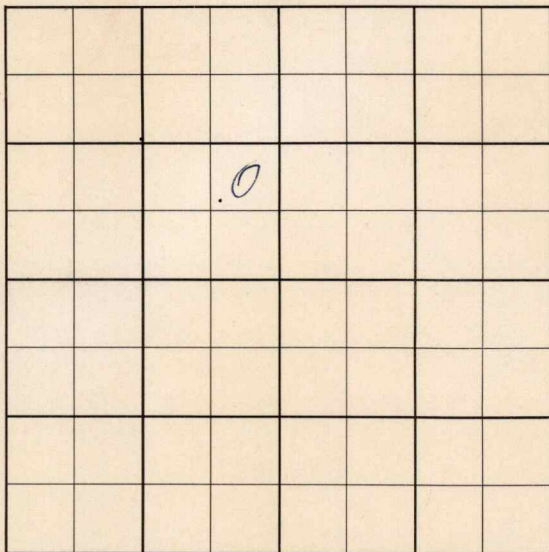

County McPherson Elev. 1464
 Sec. 28 Twp. 18 Rge. 1W
 Company Greenland Drlg.
 Farm Name Greenwood No. 8

TOPS	DEPTH	LOG	DATUM	Loc. in Sec.
Anh.				NE SE NW
Tr.				
H.				
Tr.				
Dg.				
Bl.				
L.				Geol.
K.C.				Contr.
B.K.C.				Co. tools
Ce.				Pool
C.				Maxwell
M.	2803			
M.				
K.				
Mz.				
Ma.				
V.				
S.				
S.				
A.				
R.				
Pe.				
G.				
T.D.	2840			



Date Comm. 5-6-57

MAY 15 '57 8 1/8 125/150 5 1/2

2836/175 MAY 22 '57 MAY 29 '57 JUN 5 '57

D & A hold JUN 12 '57 CO

16/2810-17 1 1/4 FU 1310'

Fluid mostly wt.

D & A.

County McPherson Elev. _____
 Sec. 28 Twp. 18 Rgs. 1W
 Company Greenland Drlg.
 Farm Name Greenwood No. 8

TOPS	DEPTH	LOG	DATUM	Loc. in Sec.
Anh.				NE SE NW
Tr.				
H.				
Tr.				
Dg.				
Bl.				
L.				Geol.
K.C.				Contr.
B.K.C.				Co. tools
Ce.				Pool
C.				Maxwell
M.				
M.				
K.				
Mz.				
Mq.				
V.				
S.				
S.				
A.				
R.				
PE.				
G.				
T.D.				

MAY 8 57
0

FIRST REPORT

Date Comm. 5-6-57