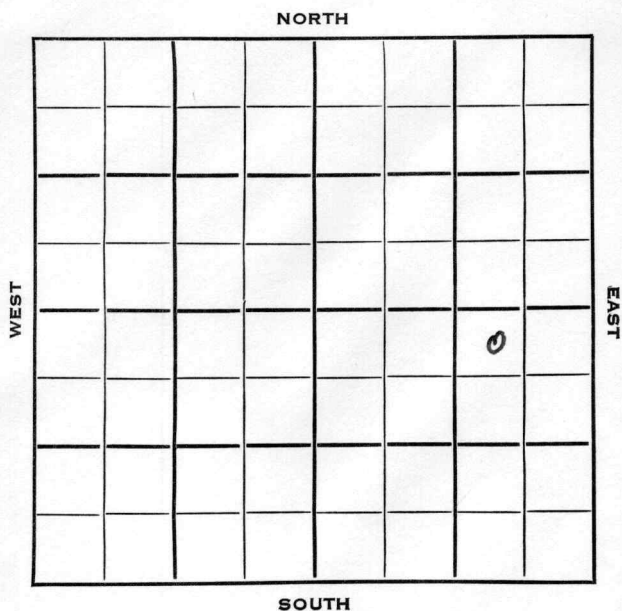


Section 14 Township 19 Range 6 WWell No. # 1 GreenCompany G-M-R Oil

Rice

KANSAS ✓

Sec. 14 Twp. 19 R. 6WWell No. #1 Green FarmG-M-R Oil

Company

G-M-R
Wildcat.

Contractor


330 Ft. from N. Line

Ft. from S. Line

990 Ft. from E. Line

Ft. from W. Line

NW NE SE

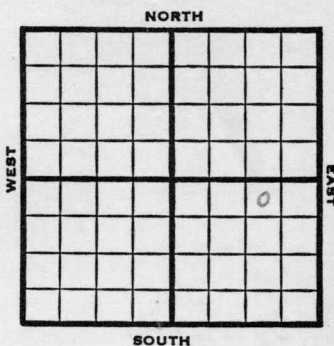

1953 Elev. 1617'

REPORT

6/3 C&P

6/10 8" @ 151'
Drlg 2198'6/24 Miss 3378
DST 3378-88' RTD 1 hr, 160' HOCM, 140#
4" @ 3380'
Cong 3326'7/1 CO 3388
2 boph / mud DD 3390 10 go / 22 gwph
DD 3404, 1 BO / 5 gwph sd-frac 2 boph
/ some w.

7/8 S/15 BO + 16 BW 16 hrs.

7/22 S/26 bo + 11 bw 21 hrs., POP

7/29 NR

8/5 P/24 BOPD & wtr.

8/12 NR

8/19 "

OVER

1953

9/9

Spud 6-4-53

Oil Well

TD 3404

8" @ 151

Miss 3378

DST 3378-88, opn 1 hr., rec. 160'

hocm, 140#

4" @ 3380

Cong 3326

CO to 3388' 2 boph

DD 3390 10 go 22 gwph

DD 3404 1 bo 5 gwph

Sd-frac 2 boph

S/15 bo 16 bw 16 hrs.


S/26 bo 11 bw 21 hrs.

P/24 bopd

Comp. 24 bopd 25% wtr.


COMPLETED

County Rice State Kansas
 Sec. 14 (Blk. 19) (Sur. 6W) (Twp. 19) (Rge. 6W) Map No. _____
 Operator G-M-R Oil
 Well No. 1 Farm Green
 Elev. _____ Location NW NE SE

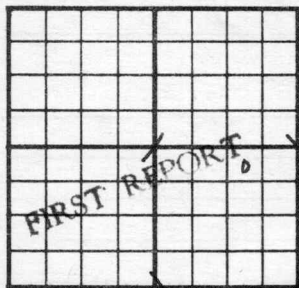

330 Ft. From N Line SE
990 Ft. From E Line Quarter
 1st. Report JUN 3 1953
 Completion _____
 Remarks G-M-R - Contr.
 Spudding Date _____

Drlg. Data Wildcat
Cellar & pits

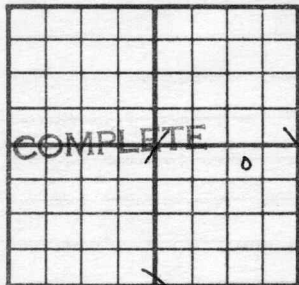County Rice State KansasSec. 14 (Blk.
Twp.) 19 (Sur.
Rge.) 6W Map No.Operator G-M-R OilWell No. 1 Farm GreenElev. 1617 Location NW NE SE330 Ft. From N Line SE990 Ft. From E Line Quarter1st. ReportCompletion SEP 9 1953Remarks WildcatG-M-R - Contr.Spudding Date 6-4-53Drlg. Data Oil well TD 34048" @ 151 Miss. 3378 DST 3378-88open 1 hr. Rec. 160' hocm 140#4" @ 3380 Cong. 3326 CO to 33882 boph DD 3390 10 go 22 gwphDD 3404 1 bo 5 gwph sd-frac2 boph S/ 15 bo 16 bw 16 hr.S/ 26 bo 11 bw 21 hr. P/ 24 bopdComp. 24 bopd 25% wtr.