


Section 17 Township 20 Range 15-W

Well No. 1 Unruh

Company Helmerich & Payne et al

Wildcat

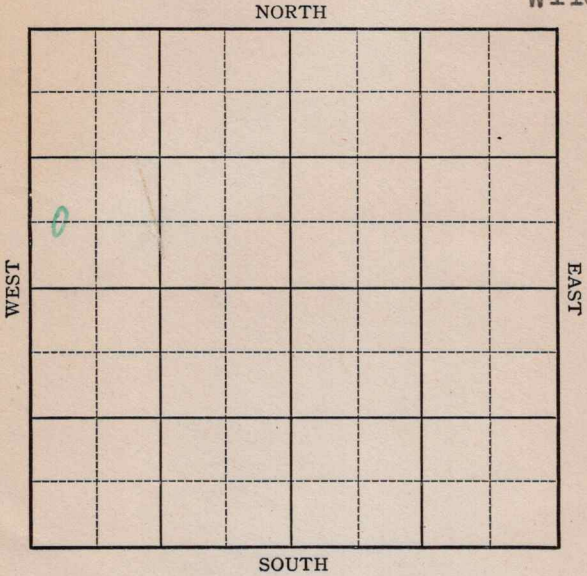

Sec. 17 Twp. 20 R. 15-W

Well No. #1 Unruh Farm

Helmerich & Payne et al Company

(Wildcat)


\_\_\_\_\_ Ft. from N. Line

660 Ft. from S. Line

\_\_\_\_\_ Ft. from E. Line

330 Ft. from W. Line

Elev. 2083

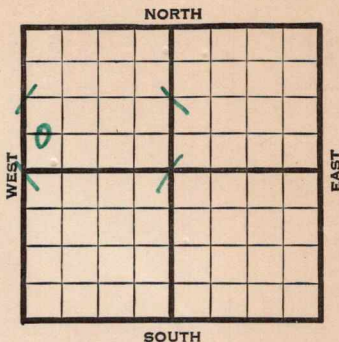

| 1941  | REPORT  |
|-------|---|
| 10/1  | Anhy. 1120' Drlg. 1991'<br>8" - 702'  |
| 10/9  | Topeka 3196' Fsg. 3419'   |
| 10/16 | Lans. 3512' Arb. 3802'<br>T.D. 3877' Some stains.<br>Circulating. Waiting on orders.  |
| 10/23 | 2 shots 3826'<br>12 " 3823-26' 1400' oil.   |
| 10/30 | " " " "   |
| 11/6  | Squeeze off perforations.<br>Drilled cement to 3841'<br>12 shots 3819-23'<br>12 " 3820-24' 4000 acid.<br>Flow 29 oil 3/4 hours.<br>36.8 Gravity |
| 11/13 | 24 shots 3814-19½' Flow 12 oil<br>per hour 4 hours.   |

OVER

751043

1941

11/19

Arb. 3799'

5" - 3874'

T.D. 3874'

24 shots 3819-24'

24 shots 3814-19½'

5000 acid.

Potential 583 bbls., pump.

28.5 Gravity

**COMPLETED**



Map No. K-82 Sec. 17 Twp. 20 R. 15W

Well No. 1 Unruh

Helmerich & Payne et al Company

**COMPLETED**

Contractor

C WL SW NW

SECTION PLAT

\_\_\_\_\_ Ft. from N. Line

660 Ft. from S. Line

\_\_\_\_\_ Ft. from E. Line

330 Ft. from W. Line

|  |  |  |  |
|--|--|--|--|
|  |  |  |  |
|  |  |  |  |
|  |  |  |  |
|  |  |  |  |
|  |  |  |  |

Wildcat

RECORD

Location \_\_\_\_\_

Cased \_\_\_\_\_ in., \_\_\_\_\_ ft.

Rig up \_\_\_\_\_

Sand \_\_\_\_\_

Drilling and Remarks:

Gas \_\_\_\_\_

Oil \_\_\_\_\_

Total Depth 3874

Cr 8,3799

5" 83874

24 hrs to 3819 - 24

24 " 3814 - 19 1/2

5000 acid

Pump 583 P.Y.

PRODUCTION

1st 24 hrs. Nat. \_\_\_\_\_

1st 24 hrs. after shot \_\_\_\_\_

Gas \_\_\_\_\_ Cu. Ft.

Dry Hole \_\_\_\_\_

Abandoned \_\_\_\_\_

285 Gr

Date

NOV 19 1941

19

S. J. LEWIS

Scout