
FORM 51 5M 10-41 PETROL KANSAS

Barton

Section 18 Township 20 Range 15-W

Well No. #1 Derkert

Company Derby Oil etal.

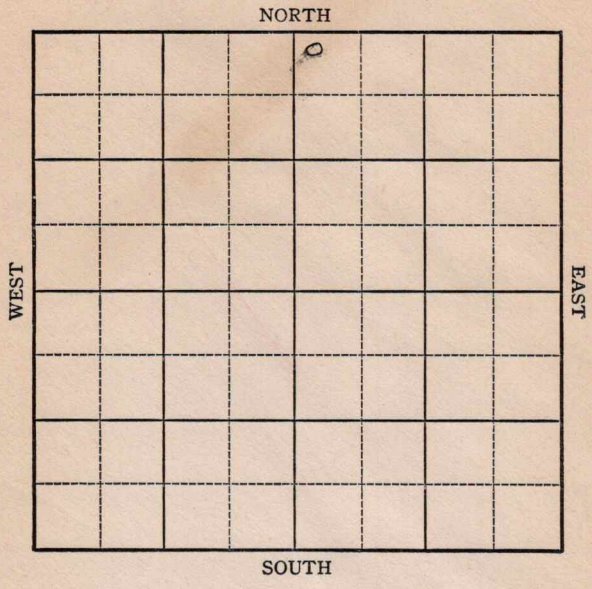

FORM 252-A
5M 9-42 GASS

KANSAS

Barton

Sec. 18 Twp. 20 R. 15-W

Well No. #1 Deckert Farm

Derby Oil etal. Company

Wildcat


330 Ft. from N. Line

Ft. from S. Line

Ft. from E. Line

330 Ft. from W. Line

Elev. 2029

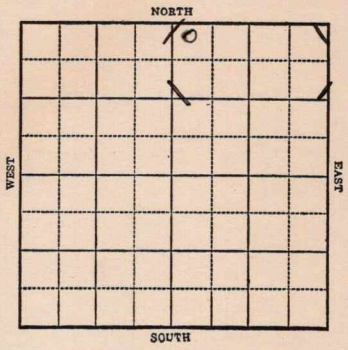

1943	REPORT
4/7	Location.
4/14	"
4/21	8" @ 850' Drlg. 2054'
4/28	Drlg. 3464'
5/5	Lans 3471 Congl. 3731 Arb. 3865 T.D. 3936' No shows.
	ABANDONED

Form 26 200 Bks 5-42 Petrol

Barton KANSAS

Map No. 82 Sec. 18 Twp. 20 R. 15W


Well No. 1 Deckert

Derby Oil etal. Company

FIRST REPORT Contractor

NW NE

SECTION PLAT

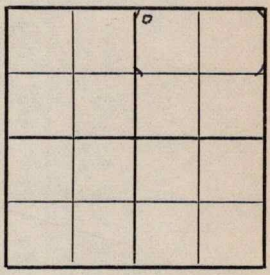

330 Ft. from N. Line

_____ Ft. from S. Line

_____ Ft. from E. Line

330 Ft. from W. Line

WILDCAT

Location XXX

Rig up

Drilling and Remarks:

RECORD

Cased _____ in., _____ ft.

Sand

Gas

Oil

Total Depth

PRODUCTION

1st 24 hrs. Nat.

1st 24 hrs. after shot

Gas _____ Cu. Ft.

Dry Hole

Abandoned

Date

APR 7 1943 19 S. J. LEWIS Scout

Form 26 200 Bks 5-42 Petrol

KANSAS

Barton

Map No. 62 Sec. 18 Twp. 20 R. 15W

Well No. 1 Deckert

Derby Oil etal. Company

ABANDONED Contractor

NW NE


330 Ft. from N. Line

_____ Ft. from S. Line

_____ Ft. from E. Line

330 Ft. from W. Line

SECTION PLAT

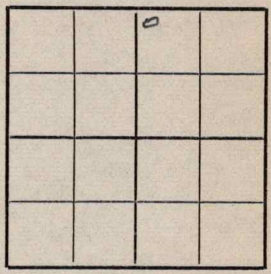

WILDCAT

Location

Rig up

Drilling and Remarks:

Lans 3471
Conq 3731
Cit 3765
Nuchaven

RECORD

Cased _____ in., _____ ft.

Sand

Gas

Oil

Total Depth 3936

PRODUCTION

1st 24 hrs. Nat.

1st 24 hrs. after shot

Gas _____ Cu. Ft.

Dry Hole

Abandoned

Date

MAY 5 1943 19

S. J. LEWIS Scout