

SECTION 33 TOWNSHIP 18 RANGE 1W


WELL NO. #1 Krehbil "A"

COMPANY Greenland Drlg.

NORTH SW SW NW

WEST

EAST

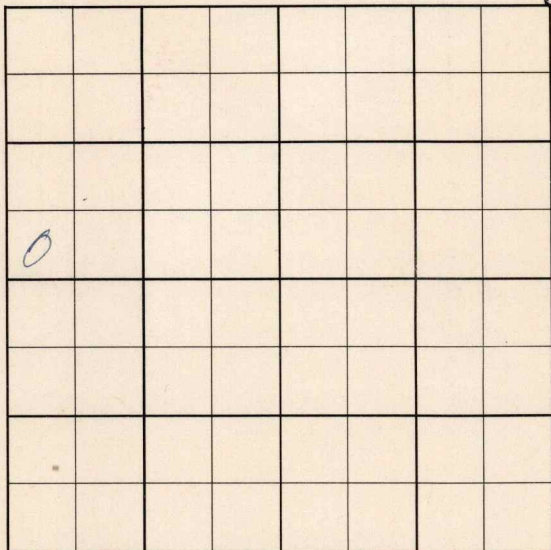

SOUTH

County McPherson Elev. \_\_\_\_\_  
 Sec. 33 Twp. 18 Rge. 1W  
 Company Greenland Drlg.  
 FarmName Krehbil No. 1

TOPS	DEPTH	LOG	DATUM
Anh.			
Tp.			
H.			
Tr.			
Dg.			
Bl.			
L.			
K.C.			
B.K.C.			
Ce.			
C.			
M.			
M.			
K.			
Mz.			
Me.			
V.			
S.			
S.			
A			
R.			
PE.			
G.			
T.D.			

Loc. in Sec. SW SW NW  
 Geol. \_\_\_\_\_  
 Contr. Co. tools

Pool Round Hill

FIRST REPORT  
 MAY 1 1957

Date Comm. 4-28-57  
8" @ 158/125 WOC

~~\_\_\_\_\_~~  
~~\_\_\_\_\_~~  
~~\_\_\_\_\_~~  
~~\_\_\_\_\_~~  
~~\_\_\_\_\_~~  
~~\_\_\_\_\_~~

Co.  
 Lse.  
 No.  
 Sec.  
 T.  
 R.

