


Section 20 Township 20 Range 15W

Well No. #1 Converse

Company Sunray Oil

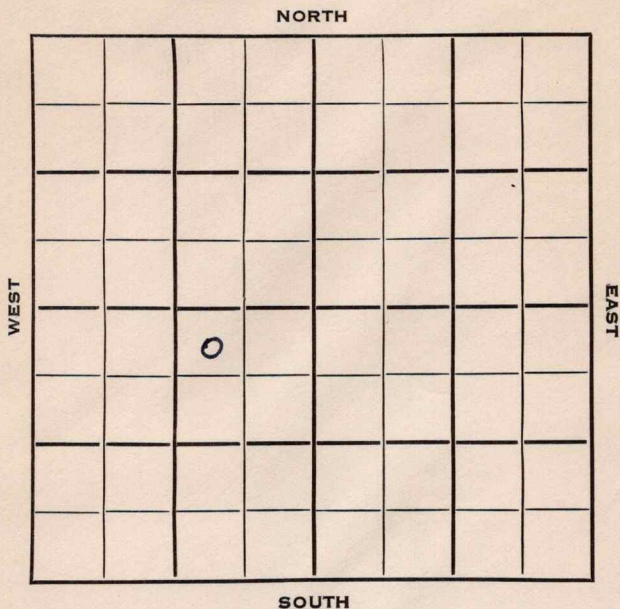

Barton
20

KANSAS
15W

20

Sec. _____ Twp. _____ R. _____

#1 Converse

Well No. _____ Farm _____

Sunray Oil

Company _____

Adkins

Contractor _____

Wildcat

330

Ft. from N. Line


Ft. from S. Line

990

Ft. from E. Line

Ft. from W. Line

NW NE SW

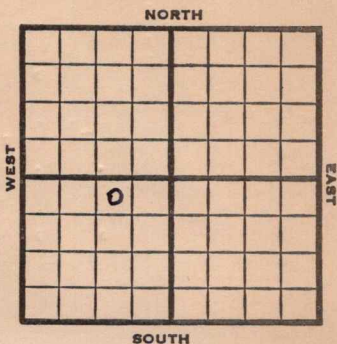

1953

Elev. 2072'

REPORT

7/29

Spud 7-26-53
Drlg. 1000'

8/5

Anhy 1069' 8" @ 1083
Drlg. 2500'

8/12

Top 3074, Heeb 3390, ^T or 3408, Doug
3424, Br 11 3478, ^L ans 3492, B KC
3723, Cong 3754, Arb 3779
DST 3782-89, 1 hr., 90' GCM, Gauge
1,710,000 ft. gas, 900#
DST 3791-3836 RTD, 1 hr., gas in 3",
470,000 + 66' gcw 980#
5" set

8/19

5" @ 3835 1/2
DD 3862, 11,000 gas, + 110' ? wtr.
DD 3874

8/26

DD 3885' 1 1/2 GOPH DD 3887' 8 GOPH
DD 3889' TD 3 1/2 GOPH & 4 GWPH
PB 3885' 1000 A Lost load.
PB 3830' 184/3783-3829' 2000 A

OVER

75105 D

1953

9/9

Spud 7-26-53

Gas Well

TD 3889

Anhy 1069'

8" @ 1083'

Top 3074, Heeb 3390, Tor 3408, Doug
3424, Br lime 3478, Lans 3492, B KC
3723, Cong ~~XXX~~ 3754, Arb. 3779

DST 3782-89, opn 1 hr., rec. 90'
gcm, 900#

DST 3791-3836, opn 1 hr., gas in
3", rec. 470,000 gas, 66' gcw, 980#
5" @ 3835

DD 3862, 11,000 cfg 110' w

DD 3874

DD 3885

1½ goph ~~XX~~

DD 3887 8 goph DD 3889 3½ goph

4 gw

PB 3885, 1000A

PB 3830, 184/3783-3829 2000A

Comp. shut in gas well

3,750,000 gas

COMPLETED

