

Section 32 Township 18 Range 1W

Well No. #1 Koehn


Company Greenland Drlg

8

NORTH

WEST

EAST

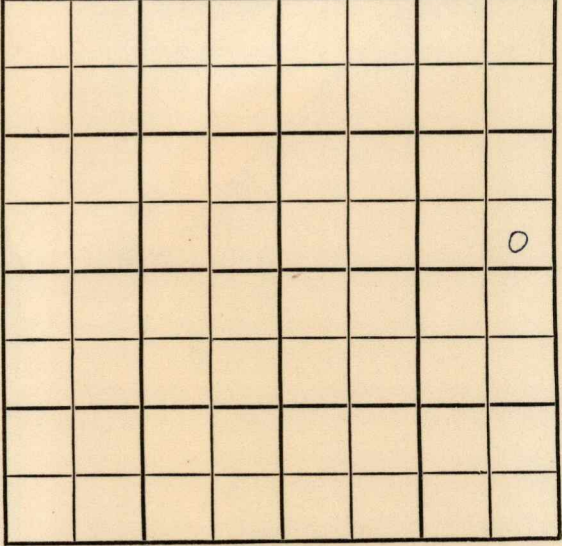

SOUTH

SEC. 32	TWP. 18	R. 1W
------------	------------	----------

WELL NO. #1 Koehn FARM

COMPANY Greenland Drlg.

CONTRACTOR


Round Hills

\_\_\_\_\_ FT. FROM N. LINE

\_\_\_\_\_ FT. FROM S. LINE

\_\_\_\_\_ FT. FROM E. LINE

\_\_\_\_\_ FT. FROM W. LINE

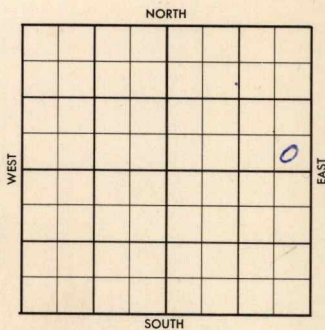

SE SE NE

1956	ELEVATION 1695'	REPORT
------	--------------------	--------

6-6 Comm. 6-4-56  
8" @ 155 w/110  
WOC

7-18 DST 2886-96 op 60 min. gas in 5 min.  
rec. 2040' GCO, no wtr., BHP 580/20".  
CO 2896  
FU 2000' oil, no/wtr, 7 hrs.  
5 1/2" @ 2887  
P/ 68 BO ≠ 20% wtr., 24 hrs.  
P/ 25 BOPD ≠ 20%  
BL. 2244'; L. 2298'; Ce. 2886';  
C. 3171'  
TD 2896'

**COMPLETED**

County McPherson Elev. 1695  
 Sec. 32 Twp. 18 Rge. 1W  
 Company Greenland Drilling  
 Farm Name Koehn No. 1

TOPS	DEPTH	LOG	DATUM	Loc. in Sec.
Anb.				SE SE NE
Tr.				
H.				
Tr.				
Dg.				
BL.	<u>2244</u>			
L.	<u>2298</u>			
K.C.				Geol.
B.K.C.				Contr.
Ce.	<u>2886</u>			
C.	<u>3171</u>			
M.				Pool
M.				Round Hills
K.				
Mz.				
Mo.				
V.				
S.				COMPLETE
S.				
A.				
R.				
PE.				
G.				
T.D.	<u>2896</u>			

COMPLETE			
JUL 1	8	1956	

Date Comm. 6-4-56

8" @ 155/110 WOC JUN 13 '56

DST 2886-96 (60) 425 (5)

fcc 2040' GCO NW BHP 580 (20)

5" @

RFD 2896 JUN 20 '56 CO 2896 FU

2000' oil no/w 7 hrs T&R

JUN 27 '56 5 1/2 @ 2887 JUL 3 '56 JUL 11 '56

JUL 18 '56 POP. P. 68 B0 + 20%

wt 24 hrs P. 25 Bopd + 20%

