

Barton


FORM 51 5M 10-41 PETROL

KANSAS

Section 17 Township 20 Range 15-W

Well No. #1 J. B. Smith

Company Helmerich & Payne

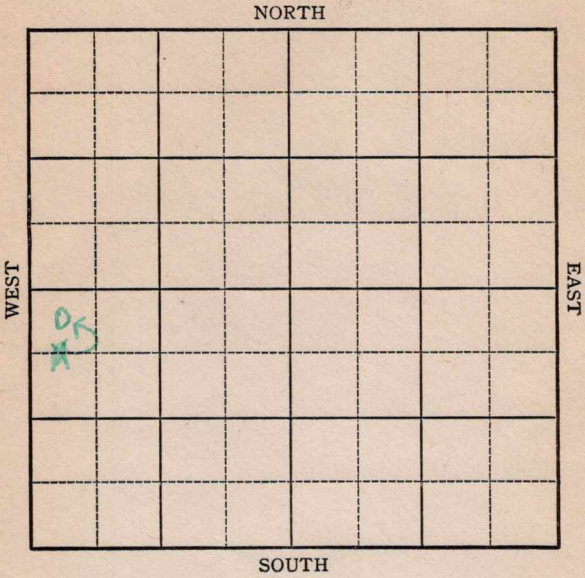

KANSAS

Barton

Sec. 17 Twp. 20 R. 15 -W

Well No. #1 J. B. Smith Farm

Helmerich & Payne Company

(Semi-Wildcat)


~~660~~ 330 Ft. from N. Line

_____ Ft. from S. Line

_____ Ft. from E. Line

330 Ft. from W. Line

Elv. 2071

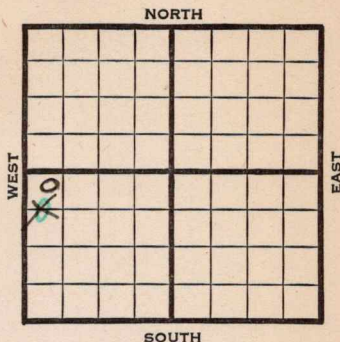

REPORT	
1941	
11/19	C & P and material.
11/28	Drlg. 2027'
12/4	Drlg. 2900' 8" - 718'
12/11	Art. 3797 5" @ 3841-42
	TD RUST SO.
12/18	14 shots 3824½ to 26½
	2000 acid Flow 14 oil per hour
12/23	Arb. 3797'
	5" - 3841'
	T.D. 3842'
	14 shots 3824½-26½'
	2000 acid.
	Potential 248 bbls., Pump & flow.
	34. Gravity
	COMPLETED

Barton

KANSAS

Map No. K 82 Sec. 17 Twp. 20 R. 15W

Well No. 1 J. B. Smith

Helmerich & Payne Company

FIRST REPORT Contractor

C WL NW SW

SECTION PLAT

660 Ft. from N. Line

_____ Ft. from S. Line

_____ Ft. from E. Line

330 Ft. from W. Line

SEMI-WILDCAT

Location _____

Rig up _____

Drilling and Remarks:
Cellar Pits
and Material

RECORD

Cased _____ in., _____ ft.

Sand _____

Gas _____

Oil _____

Total Depth _____

PRODUCTION

1st 24 hrs. Nat. _____

1st 24 hrs. after shot _____

Gas _____ Cu. Ft.

Dry Hole _____

Abandoned _____

Date

NOV 19 1941 19 _____

S. J. LEWIS

Scout

15W

Map No. K 82 Sec. 17 Twp. 20 R. ~~117~~

Well No. 1 J. B. Smith

Helmerich & Payne Company

CORRECTION Contractor

NW SW

SECTION PLAT

330 Ft. from N. Line

_____ Ft. from S. Line

_____ Ft. from E. Line

330 Ft. from W. Line

o			

SEMI-WILDCAT

Location _____

Rig up _____

Drilling and Remarks:

Reported as

C WL NW SW

RECORD

Cased _____ in., _____ ft.

Sand _____

Gas _____

Oil _____

Total Depth _____

PRODUCTION

1st 24 hrs. Nat. _____

1st 24 hrs. after shot _____

Gas _____ Cu. Ft.

Dry Hole _____

Abandoned _____

Date

DEC 3 1941 19 S. J. LEWIS Scout

Map No. 82 Sec. 17 Twp. 20 R. 15W

Well No. 1 J. B. Smith

Helmerich & Payne Company

COMPLETED Contractor

NW SW

SECTION PLAT

330 Ft. from N. Line

_____ Ft. from S. Line

_____ Ft. from E. Line

330 Ft. from W. Line

0			

SEMI WILDCAT

RECORD

Location _____

Cased _____ in., _____ ft.

Rig up _____

Sand _____

Drilling and Remarks:

Gas _____

Cor 83797

Oil _____

5' to 3841

Total Depth 3842

14 shots to 3824 1/2 - 26 1/2

2000 acid

Pump & Flow 248 P.P.T.

PRODUCTION

1st 24 hrs. Nat. _____

1st 24 hrs. after shot _____

Gas _____ Cu. Ft.

Dry Hole _____

Abandoned _____

240 Gr

Date

DEC 23 1941

19

S. J. LEWIS

Scout