

KANSAS


FORM 51 5M 10-41 PETROL

Barton

Section 18 Township 20 Range 15-W

Well No. #1 Deckert

Company Transwestern

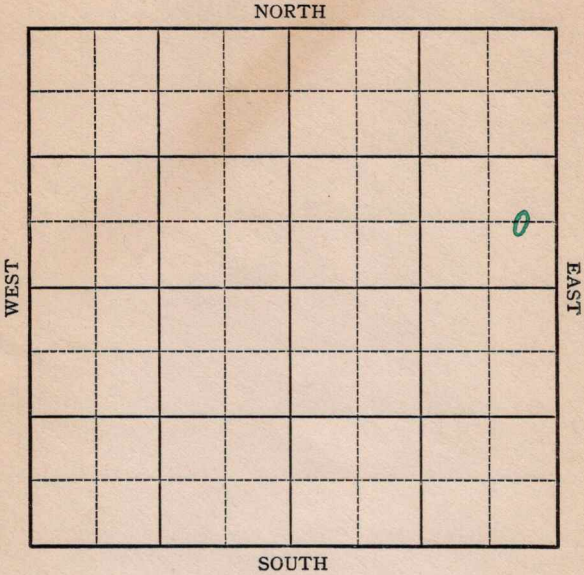

1942

2/5 Water squeeze off perforations.
36 shots 3812-19' 4000 acid.
2 M gas, 3 bbls. fluid per hour, 68%
water.

2/12	"	"	"
2/19	"	"	"
2/26	"	"	"
3/5	"	"	"
3/12	"	"	"
3/19	"	"	"
3/26	"	"	"

4/1 Arb. 3790'
5" - 3864'
T.D. 3864'
36 shots 3812-19'
4000 acid.
3,952,000 cu. ft. gas.

COMPLETED

Barton

KANSAS

Map No. 82 Sec. 18 Twp. 20 R. 15W

Well No. 1 Deckert

Transwestern Company

COMPLETED Contractor

C E L S E N E

SECTION PLAT

_____ Ft. from N. Line

660 Ft. from S. Line

330 Ft. from E. Line

_____ Ft. from W. Line

WILDCAT

Location _____

Rig up _____

Drilling and Remarks:

Cu & 3790
5" @ 3864
36 shots 3872-9
4000 acid
3,952,000 Cu &
Gas.

RECORD

Cased _____ in., _____ ft.

Sand _____

Gas _____

Oil _____

Total Depth 3864

PRODUCTION

1st 24 hrs. Nat. _____

1st 24 hrs. after shot _____

Gas _____ Cu. Ft.

Dry Hole _____

Abandoned _____

Date

APR 1 1942 19

S. J. LEWIS Scout