


Section 19 Township 20 Range 15 W

Well No. # 1 E. A. Smith "A"

Company Republic Natural

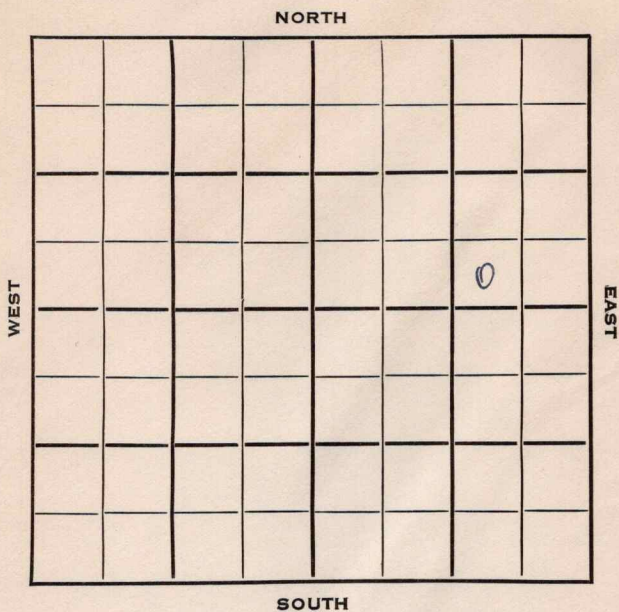


SEC. 19 TWP. 20 R. 15W

WELL NO. 1 E. A. Smith "A" FARM

COMPANY Republic Natural

CONTRACTOR Gabbert-Jones Wildcat

\_\_\_\_\_ Ft. from N. Line  
 330 \_\_\_\_\_ Ft. from S. Line  
 990 \_\_\_\_\_ Ft. from E. Line  
 \_\_\_\_\_ Ft. from W. Line

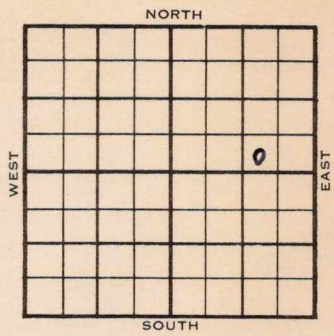

SW SE NE

1953 ELEVATION 2106' REPORT

12/16

Spud 12-13-53  
 Drlg. 746'

1954  
 1/13

Spud 12-13-53 Gas well TD 3924'  
 8" @ 1120 Heeb 3423' Br lime 3511'  
 Lans. 3523 Arb. 3816'  
 DST 3818-26 open 26 min, rec 10' wtr.  
 lot of gas.  
 DST 3725-70 open 1/2 hr rec 5,200,000  
 gas, 1100"  
 DST 3873-3924' open 1 hr rec 240'  
 HO & GCM, 860' wtr. 1100#  
 TD 3924' 5" @ 3924 Perf/3818-40  
 1 1/4 MCFG 500 A 6 MCFG  
 Comp. shut in gas well

**COMPLETED**



County Barton State Kansas

Sec. 19 (Blk. 20) (Twp. 15W) (Sur. Rge.) 15W Map No.

Operator Republic Natural

Well No. 1 Farm E. A. Smith "A"

Elev. 2106 Location SW SE NE

|  |  |  |  |  |  |
|--|--|--|--|--|--|
|  |  |  |  |  |  |
|  |  |  |  |  |  |
330 Ft. From S Line NE

990 Ft. From E Line Quarter

1st. Report

Completion JAN 13 1954

Remarks Wildcat

Gabbert-Jones - Contr.

Spudding Date 12-13-53

Drlg. Data Gas well TD 3924

8" @ 1120 Heeb. 3423 Br. lime 3511

Lans. 3523 Arb. 3816 DST 3818-26

open 26 min. Rec. 10' wtr. lot of gas

DST 3725-70 open  $\frac{1}{2}$  hr. Rec. 5,200,000 gas

1100" DST 3873-3924 open 1 hr. Rec.

240' ho & gcm 860' wtr. 1100#

TD 3924 5" @ 3924 perf/ 3818-40

1 $\frac{1}{4}$  mcfg 500 A 6 mcfg

Comp. shut in gas well