


Section 1 Township 18 Range 2W
Well No. #3 Anderson
Company Westgate-Greenland

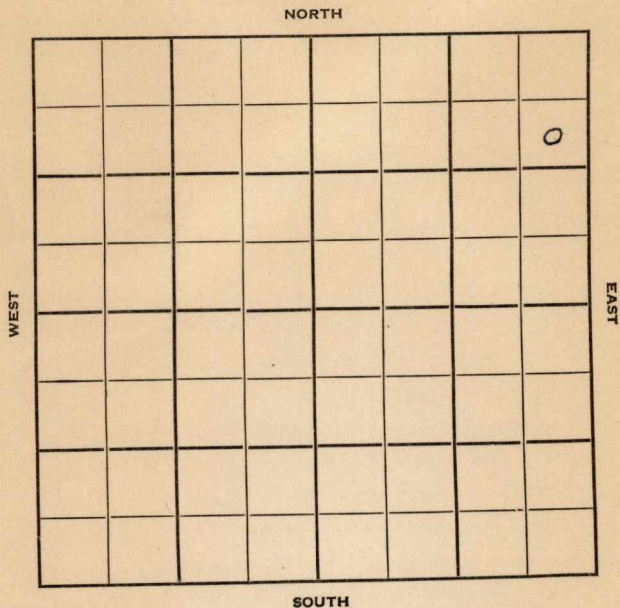

Sec. 1 Twp. 18 R. 2W

Well No. #3 Anderson Farm

Westbate-Greenland

(Mallard Drlg., Contr.) Company

Twin Mound Pool


990' Ft. from N. Line

 Ft. from S. Line

330' Ft. from E. Line

 Ft. from W. Line

SE NE NE

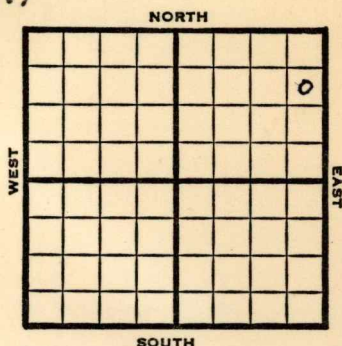

1950

Elev. 1399' REPORT

1/11

Spud 1-6-50

8" @ 126'

Anhy 415'

Drlg. 1390'

1950

2/22

8" @ 126'

5" @ 2790'

152 BOPD, 10% wtr

TD 2792'

COMPLETED

Kansas

Map No. _____ Sec. 1 Twp. 18 R. 2WWell No. 3 AndersonWestgate-Greenland CompanyMallard Drlg. Contractor

SE NE NE

SECTION PLAT

			0
FIRST REPORT			

990 Ft. from N. Line Ft. from S. Line330 Ft. from E. Line Ft. from W. LineMcPherson County

Location _____

Rig up _____

Drilling and Remarks:

Spud 1-6-50

8" @ 126

Anhy 415

drlg. 1390

RECORD

Cased _____ in., _____ ft.

Sand _____

Gas _____

Oil _____

Total Depth _____

PRODUCTION

1st 24 hrs. Nat. _____

1st 24 hrs. after shot _____

Gas _____ Cu. Ft.

Dry Hole _____

Abandoned _____

Date

JAN 11 1950 19J. E. TYRA

Scout

Map No. _____ Sec. 1 Twp. 18 R. 2WWell No. 3 AndersonWestgate-Greenland Company

Contractor


SE NE NE

E. 1399
SECTION PLAT990 Ft. from N. Line

_____ Ft. from S. Line

330 Ft. from E. Line

_____ Ft. from W. Line

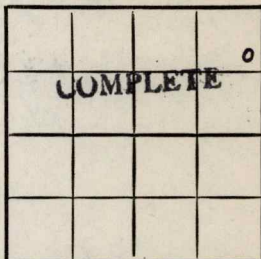McPherson County

Location _____

Rig up _____

Drilling and Remarks:

8" @ 1265" @ 2790152 BOPD10% wtr.

RECORD

Cased _____ in., _____ ft.

Sand _____

Gas _____

Oil _____

Total Depth 2792

PRODUCTION

1st 24 hrs. Nat. _____

1st 24 hrs. after shot _____

Gas _____ Cu. Ft.

Dry Hole _____

Abandoned _____

Date

J. E. TYRAFEB 22 1950 19

Scout