

KANSAS


Barton

FORM 51 5M 4-41 PETROL

Section 22 Township 20 Range 16W


Well No. #1 J. J. Schmidt

Company Helmerich & Payne

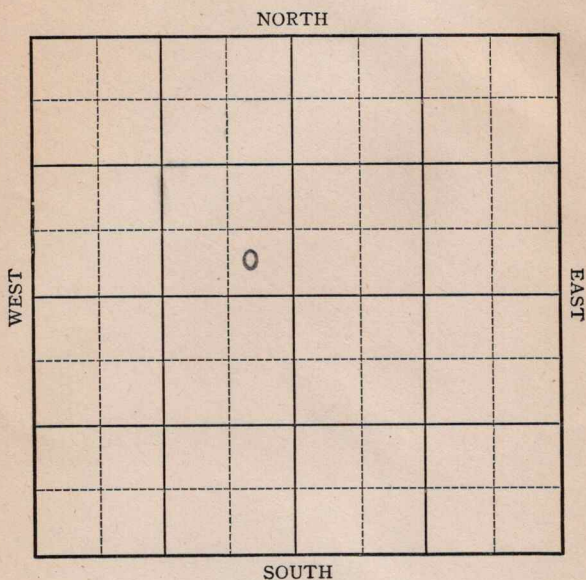

Sec. 22 Twp. 20 R. 15 -WWell No. #1 J. J. Schmidt FarmHelmerich & Payne Company

(Wildcat)

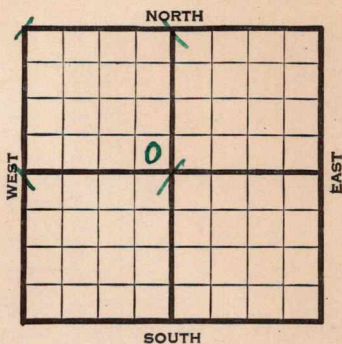 Ft. from N. Line330 Ft. from S. Line330 Ft. from E. Line Ft. from W. Line

Elev. 1963

1941

REPORT

9/3 8" - 690' WOC.

9/11 Topeka 3040' Drlg. 3130'

9/18 Lans. 3358' Arb. 3667'

T.D. 3762' SO in cuttings.

5" - 3760' RUST.

9/25 20 shots 3688-91½' 500 acid.

Flow 1/2 oil per hour.

27. Gravity

10/2 23 shots 3718-25'

22 " 3703-11' 1000 acid.

Testing.

10/8 Arb. 3667'

5" - 3760'

T.D. 3762'

20 shots 3688-91½'

23 " 3718-25'

22 " 3703-11'

1500 acid.

Potential 13 bbls., flow.

1½ M gas. 28. Gravity


COMPLETED

Map No. 82 Sec. 22 Twp. 20 R. 15WWell No. 1 J. J. SchmidtHelmerich & Payne CompanyFIRST REPORT Contractor

SE NW

 Ft. from N. Line330 Ft. from S. Line330 Ft. from E. Line Ft. from W. Line

SECTION PLAT

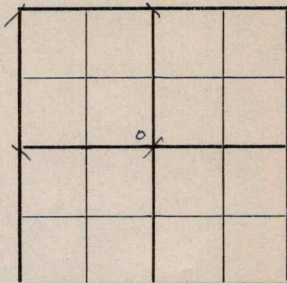

WILDCAT

Location Rig up

Drilling and Remarks:

8" - 690

WOC

RECORD

Cased in., ft.Sand Gas Oil Total Depth

PRODUCTION

1st 24 hrs. Nat. 1st 24 hrs. after shot Gas Cu. Ft.Dry Hole Abandoned

Date


SEP 3 1941 19

S. J. LEWIS Scout

Map No. K-82 Sec. 22 Twp. 20 R. 15WWell No. 1 J. J. SchmidtHelmerich & Payne CompanyCOMPLETED Contractor

SE NW

SECTION PLAT

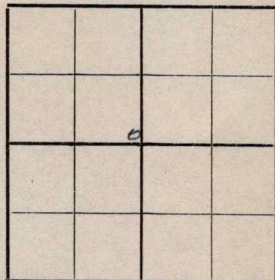 Ft. from N. Line330 Ft. from S. Line330 Ft. from E. Line Ft. from W. Line

WILDCAT

Location Rig up

Drilling and Remarks:

Cr 836675" @ 376020 x hr to 3658-91 1/228 " 3718-2522 " 3703-111500 acidFlow 13 Bx.1 1/2 M Gas

Date

280 Gr.

RECORD

Cased in., ft.Sand Gas Oil Total Depth 3762

PRODUCTION

1st 24 hrs. Nat. 1st 24 hrs. after shot Gas Cu. Ft.Dry Hole Abandoned OCT 8 1941 19S. J. LEWIS Scout