

KANSAS

McPherson

Section 1 Township 18 Range 2-W

Well No. #1 Anderson

Company Westgate-Greenland et al

NORTH

Wildcat

WEST

EAST

							0

SOUTH

KANSAS

McPherson

Sec. 1 Twp. 18 R. 2W ✓

Well No. 1 Anderson Farm

Westgate-Greenland et al Company

Mallard Contr.

Wildcat


NORTH

330 Ft. from N. Line

_____ Ft. from S. Line

330 Ft. from E. Line

_____ Ft. from W. Line

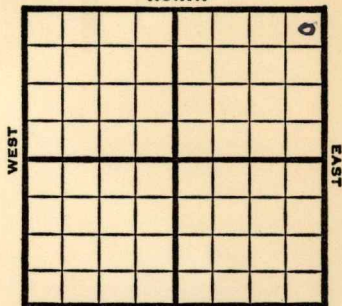

NE/C

1949

Elev 1387'

REPORT

7/27

Location

8/3

8" @ 130'

Drlg 1637'

8/10

Miss 2740-46

TD 2746

5" @ 2741'

8/17

TD 2748'

500 acid

8/24

TD 2749'

Miss 2740'

5" @ 2741'

1000 acid

Pump 100 oil Pot

39° Gr.

Comp

COMPLETED

Kansas

Wildcat

Map No. _____ Sec. 1 Twp. 18 R. 2W

Well No. 1 Anderson

Westgate-Greenland etal Company

Mallard Contractor

NE/C


FIRST REPORT
SECTION PLAT

330 Ft. from N. Line

_____ Ft. from S. Line

330 Ft. from E. Line

_____ Ft. from W. Line

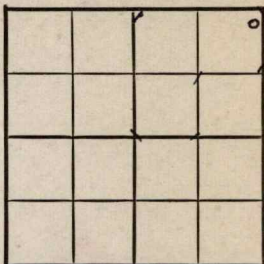

McPherson County

Location ✓

Rig up _____

Drilling and Remarks: _____

RECORD

Cased _____ in., _____ ft.

Sand _____

Gas _____

Oil _____

Total Depth _____

PRODUCTION

1st 24 hrs. Nat. _____

1st 24 hrs. after shot _____

Gas _____ Cu. Ft.

Dry Hole _____

Abandoned _____

Date

JUL 27 1949 19

S. J. LEWIS Scout

Map No. 1542 Sec. 1 Twp. 18 R. 2W

Well No. 1 Anderson

Westgate-Greenland etal. Company

COMPLETE

Contractor

NE/C

E. 1387

SECTION PLAT

330 Ft. from N. Line

_____ Ft. from S. Line

330 Ft. from E. Line

_____ Ft. from W. Line

			o

McPherson County

Location _____

Rig up _____

Drilling and Remarks:

Miss 2740
5' @ 2741.
10000 and
Pump 100 oil per
290

RECORD

Cased _____ in., _____ ft.

Sand _____

Gas _____

Oil _____

Total Depth 2749

PRODUCTION

1st 24 hrs. Nat. _____

1st 24 hrs. after shot _____

Gas _____ Cu. Ft.

Dry Hole _____

Abandoned _____

Date

AUG 24 1949 19

S. J. LEWIS Scout