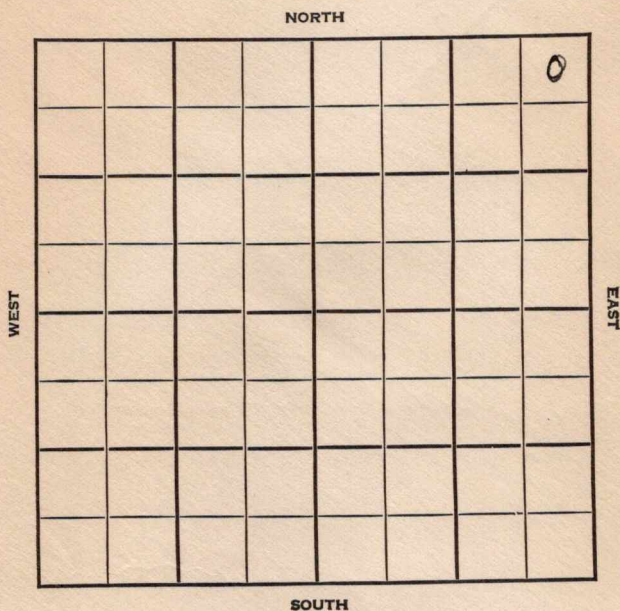


Section 23 Township 20 Range 15WWell No. #1 BrewerCompany Harbar et al.

KANSAS

Barton

Sec. 23 Twp. 20 R. 15W

Well No. #1 Brewer Farm

Harbar et al Company

Unruh Pool

NORTH


330' Ft. from N. Line

Ft. from S. Line

330' Ft. from E. Line

Ft. from W. Line

NE/C

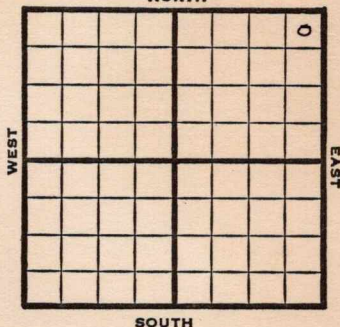

SOUTH

1948

E 11 1928'

REPORT

5/12 Location

5/19 8" @ 902'
Drlg. 2318'

5/26 Arbuckle 3591'
Drlg. 3659'

6/1 5" @ 3683' TD

6/9 21 shots 2659 $\frac{1}{2}$ -53
Swb 28 bbls W / 1 $\frac{1}{2}$ bbls oil PH

6/16 "

6/23 "

6/29 12 shots 3353-60
250 acid swb 1 bbl oil & 4 W PH

7/8 " "

7/14 " "

7/ 21 TD 3683'

Lansing 3317'

Arb. 3587'

5"@ 3683'

Perf Lans. 250 acid

Pump 18 Oil / 75% W in Pot

39° Gr.

Comp.

COMPLETED

Map No. _____ Sec. 23 Twp. 20 R. 15W

Well No. 1 Brewer

Harbar et al. Company

FIRST REPORT

Contractor

NE/C


SECTION PLAT

330 Ft. from N. Line

_____ Ft. from S. Line

330 Ft. from E. Line

_____ Ft. from W. Line

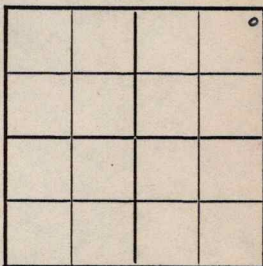

Barton County

Location X

Rig up _____

Drilling and Remarks:

RECORD

Cased _____ in., _____ ft.

Sand _____

Gas _____

Oil _____

Total Depth _____

PRODUCTION

1st 24 hrs. Nat. _____

1st 24 hrs. after shot _____

Gas _____ Cu. Ft.

Dry Hole _____

Abandoned _____

Date

MAY 12 1948 19 _____ S. J. LEWIS Scout

Map No. 82 Sec. 23 Twp. 20 R. 15WWell No. 1 BrewerHarbar et al. Company

COMPLETE

Contractor

NE/C

E. H. 1928

SECTION PLAT

330 Ft. from N. Line Ft. from S. Line330 Ft. from E. Line Ft. from W. Line

			4

Barton CountyLocation Rig up

Drilling and Remarks:

Land 3317Ac 433.875" @ 3683Prof 4 in.2800 andPump 180 ft + 25% W29. 29.24

RECORD

Cased in., ft.Sand Gas Oil Total Depth 3683

PRODUCTION

1st 24 hrs. Nat. 1st 24 hrs. after shot Gas Cu. Ft.Dry Hole Abandoned

Date

JUL 21 194819S. J. LEWIS Scout