
Rice

KANSAS

SECTION 3 TOWNSHIP 19S RANGE 6W

WELL NO. #2 Kasparek

COMPANY Rupp-Ferguson

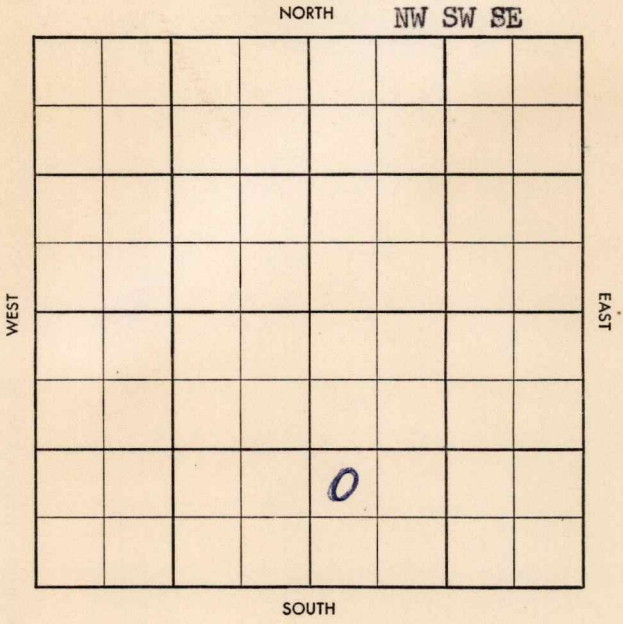

FORM 504-3 SUNRAY

47

S-513-A

CO. Rice ELEV 1658DF

SEC. 3 TWP. 19 RGE. 6W

COMPANY Rupp-Ferguson NO. 2

FIRST REPORT
JAN 8 '58

FARM Kasparek

LOC. NW SW SE

GEOL.

CONTR Co. Tools

POOL Rellim

SPUD 1/6/58

8" @ 210 w/110 Drlg.

1620.

CO. LSE. NO. SEC. TWP. RGE.

S-513-A

CO. Rice ELEV. 1661KB 1658DF

SEC. 3 TWP. 19 RGE. 6W

COMPANY Rupp-Ferguson NO. 2

FEB 26 58

COMPLETE

FARM Kasparek

LOC. NW SW SE

lt	2590
Dg	2617
BL	2743
L	2782
Bkc	3188
Sdy C	3265
Chrty C	3300
M	3315
lc	3368
TD	3375

GEOL.

CONTR Co. Tools

POOL Rellim

SPUD 1/6/58

8" @ 210 w/110 Drlg.

1620. JAN 15 58 5"

3374 woc

JAN 22 58 20/3303-08

16/3314-18 16/

3318-22 24/3326-32

24/3330-40 20/3340-45

FU 1600' oil NW 1hr $

40 BOph NW 5 hrs $150

ph + 5 - 1090 W T&R JAN 29 58

FEB 5 58 FEB 12 58 FEB 19 58 FEB 26 58 pop

pot 116 BOpd NW

CO. LSE. NO. SEC. TWP. RGE.