


Map No. **KANSAS** Sec. **31** Twp. **24** R. **13**
Well No. **1- Christy** Farm
Chas. Christy Company

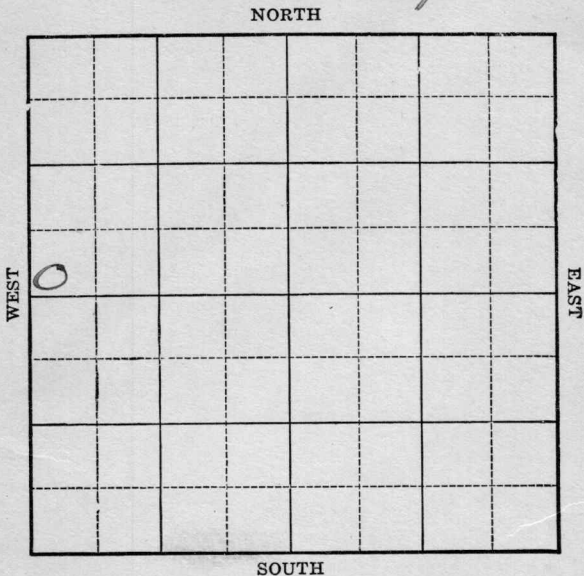

Location _____
Drilling Remarks _____

Rig Up _____
Drilling Remarks _____

RECORD

Cased _____ in. _____ ft.
Sand _____
Gas _____
Oil _____
Total Depth _____

PRODUCTION


1st 24 hrs. Nat. _____
1st 24 hrs. after shot _____
Gas _____ cu. ft.
Dry Hole _____
Abandoned _____

Map No. **KANSAS** Sec. **31** Twp. **24** R. **13**Well No. **1-Christy** Farm
Chas. Christy Company

Ft. from N. Line

250 Ft. from S. Line

Ft. from E. Line

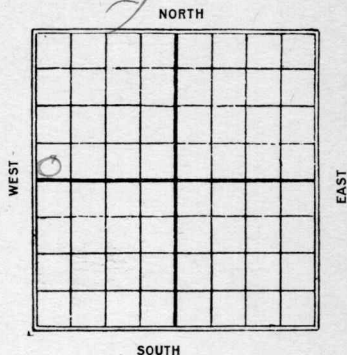250 Ft. from W. Line**1927**

Date

REPORT

11/30	Rign up machine
12/7	Trigging up
12/14	
12/21	Spudding
12/29	Spudding 300.
1928	
1/5	S.D. 625
1/11	
1/18	Drlg 1220-
1/26	" 1350
2/2	" 1600
2/9	Top line 1651
	Pay 1665-88
	T.D. 1689 P.B. to 1686
	5 bbb

no MANSAS

Map No. _____ Sec. 31 Twp. 24 R. 13^EWell No. 1 ChristyChas Christy Company

Contractor

FIRST REPORTS

SECTION PLAT

_____ Ft. from N. Line

250 Ft. from S. Line

_____ Ft. from E. Line

250 Ft. from W. Line

Location _____

Rig up _____

Drilling and Remarks:

Rign up Machine

RECORD

Cased _____ in., _____ ft.

Sand _____

Gas _____

Oil _____

Total Depth _____

PRODUCTION

1st 24 hrs. Nat. _____

1st 24 hrs. after shot _____

Gas _____ Cu. Ft.

Dry Hole _____

Abandoned _____

Date

NOV 30 1927

CHAS. L. SHERWOOD

192

Scout

Sherwood

Map No. *no tracing* **KANSAS** Sec. *31* Twp. *24* R. *13*

Well No. *1* *Christy*

Chas Christy

Company

Contractor

COMPLETED

SECTION PLAT

o			

_____ Ft. from N. Line

250 _____ Ft. from S. Line

_____ Ft. from E. Line

250 _____ Ft. from W. Line

Location _____

Rig up _____

Drilling and Remarks:

Top line 1651'

Log 1665-88

2D 1689' PB to 1686'

5 Bl.

RECORD

Cased _____ in., _____ ft.

Sand _____

Gas _____

Oil _____

Total Depth _____

PRODUCTION

1st 24 hrs. Nat. _____

1st 24 hrs. after shot _____

Gas _____ Cu. Ft.

Dry Hole _____

Abandoned _____

Date

FEB 9 1928

CHAS. L. SHERWOOD

192

Scout