


Section 4 Township 19 Range 6WWell No. #1 AlmquistCompany Atlantic

Adessa Pool

NORTH

WEST

EAST

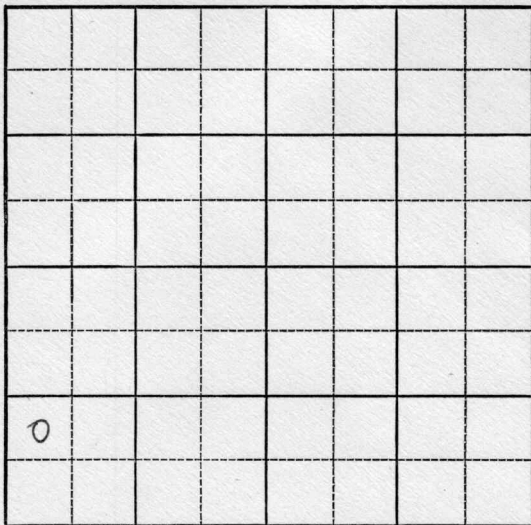

SOUTH

Sec. 4 Twp. 19 R. 6W

Well No. #1 Almquist Farm

Atlantic

Company

Adessa Pool

(Herndon Drilling Contr.)

Ft. from N. Line

990'


Ft. from S. Line

Ft. from E. Line

330'

Ft. from W. Line

NW SW SW

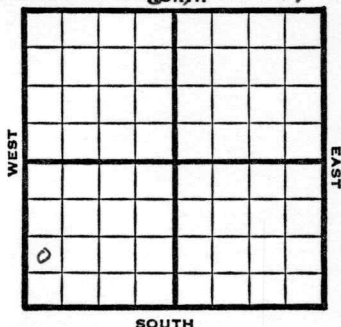

1949

Elev 1631'

REPORT

12/7

RUR

12/14

8" @ 252'

Lansing 2736'

Drilg. 2790'

12/21

TD 3150'

5" @ 3149'

12/28

20 shots 3072-77

3000 acid

1950

1/18

TD 3150'

8" @ 252'

5" @ 3149'

P 56 BOPD

Heeb 2554'

Lans 2736'

Comp

COMPLETED

Map No. _____ Sec. 4 Twp. 19 R. 6 W

Well No. 1 Almquist

Atlantic

Company

Herndon Drlg.

Contractor

NW SW SW


**FIRST REPORT
SECTION PLAT**

_____ Ft. from N. Line

990 Ft. from S. Line

_____ Ft. from E. Line

330 Ft. from W. Line

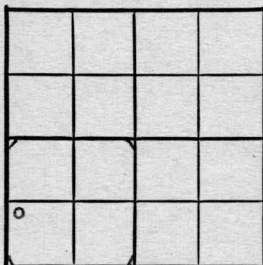

Rice County

Location _____

Rig up _____

Drilling and Remarks: _____

R U R

RECORD

Cased _____ in., _____ ft.

Sand _____

Gas _____

Oil _____

Total Depth _____

PRODUCTION

1st 24 hrs. Nat. _____

1st 24 hrs. after shot _____

Gas _____ Cu. Ft.

Dry Hole _____

Abandoned _____

Date

DEC 7 1949 19

S. J. LEWIS

Scout

Map No. _____ Sec. ^{Kansas} 4 Twp. 19 R. 6W

Well No. 1 Almquist

Atlantic

Company

Contractor

NW SW SW

EL 1631
SECTION PLAT



_____ Ft. from N. Line

990 _____ Ft. from S. Line

_____ Ft. from E. Line

330 _____ Ft. from W. Line

Rice County

Location _____

Rig up _____

Drilling and Remarks:

8" @ 252

5" @ 3149

P-56 BOPD

RECORD

Cased _____ in., _____ ft.

Sand _____

Gas _____

Oil _____

Total Depth 3150

PRODUCTION

1st 24 hrs. Nat. _____

1st 24 hrs. after shot _____

Gas _____ Cu. Ft.

Dry Hole _____

Abandoned _____

Date


JAN 18 1950

19

J. E. TYRA

Scout

Hub. - 2554
Lans - 2736

 

Scout Cards
Land Small Map
Land Wall Map
Tracings
France Map
Pierce Map
Misc.

JAN 2 1961