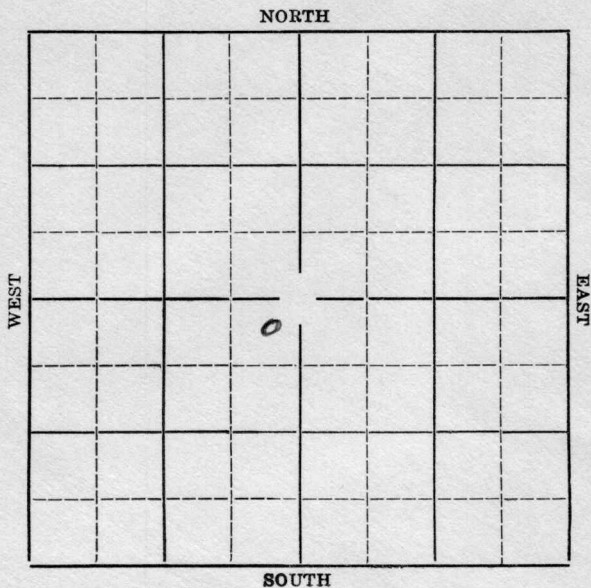


Section 6 Township 19 Range 9-WWell Number #1 WillardCompany Sinclair-Prairie Cities Service

O. W. D. D

Rice

Map No. **KANSAS** Sec. **6** Twp. **19** R. **9W**

Well No. **#1 Willard** Farm

City **Sinclair-Prairie** Company
Service


330' Ft. from N. Line

_____ Ft. from S. Line

330' Ft. from E. Line

_____ Ft. from W. Line

Elev. 1711

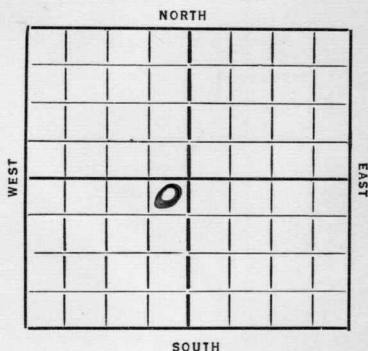

Date **1936** REPORT

7/22 Building rig.

7/30 16" @ 160'. Drlg. 1245'.

8/6 Drlg. 2715'.

8/10 Top Siliceous 3240 T.D. 3245

Small show oil Running pipe (Tel)

8/13 Siliceous 3240'. 7" @ 3245'.

Waiting on cement.

8/20 T.D. 3255½'. Swab 2 bbls per hour.

8/27 Plug back to 3254'. 1000 gallons of acid. No test.

9/2/36-Sil. 3238'.

~~T.D. 3255½'~~ T.D. 3255½'.

1000 gallons of acid.

Potential 158 bbls of oil and no water.

COMPLETED

1950 O. W. D. D

10/4 7" @ 3240 OTD 3255 Drlg to 3720TD

5" @ 3307 3000 A Comp for SWD

FIRST REPORT

COMPLETED

Rice
Map No. 49 Sec. 6 Twp. 19 R. 9W

Well No. 1 Willard

Sinclair - Prairie Company

Contractor

SECTION PLAT

		0	

330 Ft. from N. Line

_____ Ft. from S. Line

330 Ft. from E. Line

_____ Ft. from W. Line

FIRST REPORT

Location _____

Rig up _____

Drilling and Remarks:

Building rig

RECORD

Cased _____ in., _____ ft.

Sand _____

Gas _____

Oil _____

Total Depth _____

PRODUCTION

1st 24 hrs. Nat. _____

1st 24 hrs. after shot _____

Gas _____ Cu. Ft.

Dry Hole _____

Abandoned _____

Date

JUL 22 1936 19

S. J. LEWIS

Scout

KANSAS

Map No. 49 Sec. 6 Twp. 19 R. 9WWell No. 1 WillardSinclair Prairie Company

Contractor

SECTION PLAT

	0		

330 Ft. from N. Line

_____ Ft. from S. Line

330 Ft. from E. Line

_____ Ft. from W. Line

COMPLETED

Location _____

Rig up _____

Drilling and Remarks:

Sil 3238.1000 acidPa 8 158 ydsoil No water

RECORD

Cased _____ in., _____ ft.

Sand _____

Gas _____

Oil _____

Total Depth 3255 1/2

PRODUCTION

1st 24 hrs. Nat. _____

1st 24 hrs. after shot _____

Gas _____ Cu. Ft.

Dry Hole _____


Abandoned _____

Date

SEP 2 1936 19

S. J. LEWIS Scout

County Rice State Kansas
 Sec. 6 (Blk.) 19 (Sur.) 9W Map No.
 Operator Cities Service (was Sinclair)
 Well No. 1 Farm Willard SWD
 Elev. 1711 Location NE NE SW

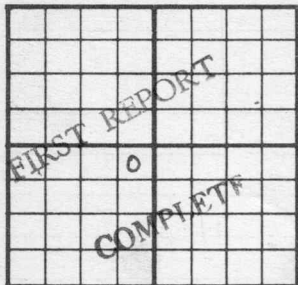

330 Ft. From N Line SW
330 Ft. From E Line Quarter
 1st. Report OCT 4 1950
 Completion OCT 4 1950
 Remarks OWDD for SWD

Spudding Date

Drlg. Data SWD well TD 3720
7" @ 3240 OTD 3255 drld. to 3720 TD
5" @ 3307 3000 A Comp. for SWD

J. E. TYRA