

KANSAS

Greenwood

Section 31 Township 24 Range 13E

Well No. #1 M. E. Church

Company Edwards Drlg. etal

		NORTH				Misc.	
WEST							
	0						
		SOUTH					

Greenwood KANSAS

Sec. 31 Twp. 24 R. 13E ✓

Well No. #1 M. E. Church Farm

Edwards Drlg. et al

Miscellaneous Company


990' Ft. from N. Line

_____ Ft. from S. Line

_____ Ft. from E. Line

330' Ft. from W. Line

SW NW NW

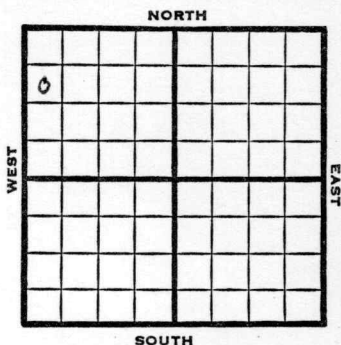

1949

REPORT

8/17

8" @ 90'

8/24

"

8/31

TD 1729'

Bart 1625'

Miss 1707'

Aband.

ABANDONED

Kansas

Map No. _____ Sec. 31 Twp. 24 R. 13EWell No. 1 M. E. Church

Edwards Drlg. etal.

Company _____

Edwards


Contractor _____

SW NW NW

FIRST REPORT
SECTION PLAT990 Ft. from N. Line

_____ Ft. from S. Line

_____ Ft. from E. Line

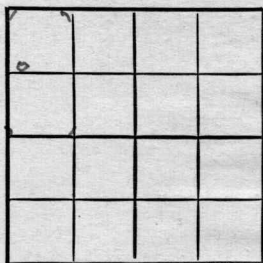330 Ft. from W. Line

Greenwood County

RECORD

Location _____

Cased _____ in., _____ ft.

Rig up _____

Sand _____

Drilling and Remarks:

Gas _____

Oil _____

Total Depth _____

8" @ 90

PRODUCTION

1st 24 hrs. Nat. _____

1st 24 hrs. after shot _____

Gas _____ Cu. Ft.

Dry Hole _____

Abandoned _____

Date

AUG 17 1949 19S. J. LEWIS

Scout

Map No. K17 Sec. 31 Twp. 24 R. 13E

Well No. 1 M. E. Church

Edwards Drlg. etal. Company

ABANDONED Contractor

SW NW NW

SECTION PLAT

990 Ft. from N. Line

 Ft. from S. Line

 Ft. from E. Line

330 Ft. from W. Line

d			

Greenwood County

Location

Rig up

Drilling and Remarks:

Bar #1625

Misc 1707

RECORD

Cased in., ft.

Sand

Gas

Oil

Total Depth 1729

PRODUCTION

1st 24 hrs. Nat.

1st 24 hrs. after shot

Gas Cu. Ft.

Dry Hole

Abandoned

Date

AUG 31 1949

19

S. J. LEWIS

Scout