


Section 10 Township 24 Range 13E

Well No. #5 Kimbell

Company R. E. Smith

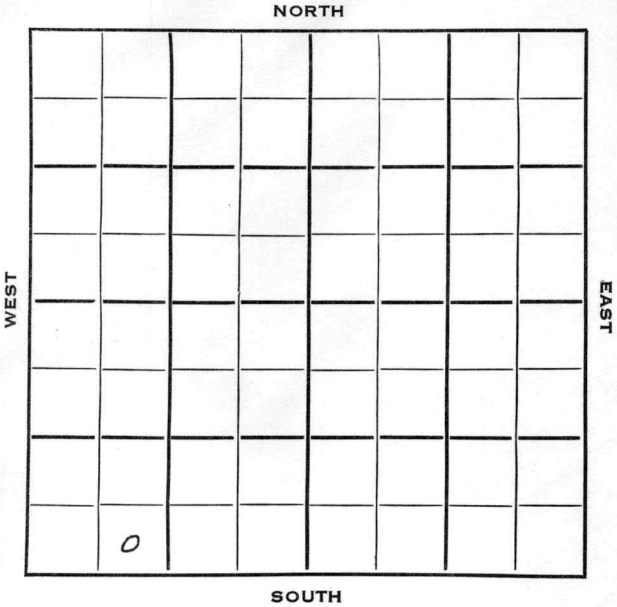

Greenwood

KANSAS ✓

Sec. 10 Twp. 24 R. 13E

Well No. #5 Kimbell Farm

R. E. Smith Company

Blackwell Pool Contractor


Ft. from N. Line

330 Ft. from S. Line

Ft. from E. Line

990 Ft. from W. Line

SE SW SW

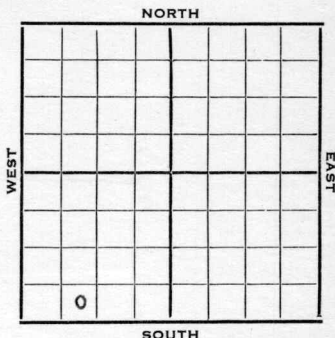

1953 Elev. - REPORT

2/25 Spud 2-25-53

4/1 Spud 2-25-53 D & A TD 1700'
10" @ 278 Miss 1640' 5" @ 1647
1000 A TD 1649 DD 1700
D & A

ABANDONED

County Greenwood State Kansas
 Sec. 10 (Blk.) 24 (Sur.) 13E Map No. (Twp.) Rge.
 Operator R. E. Smith
 Well No. 5 Farm Kimbell
 Elev. _____ Location SE SW SW



330 Ft. From S Line SW
990 Ft. From W Line Quarter

1st. Report

Completion APR 1 1953

Remarks Blackwell Pool

Spudding Date 2-25-53

Drlg. Data D & A TD 1700

10" @ 278 Miss. 1640 5" @ 1647

1000 A TD 1649 DD 1700

D & A