

NORTH

WEST

EAST

SOUTH

Drilling Remarks

Drilling Remarks

RECORD

Cased _____ in. _____ ft.

Sand

Gas

Oil

Total Depth.....

PRODUCTION

1st 24 hrs. Nat.

1st. 24 hrs. after shot_____

Gas _____ cu. ft.

Dry Hole_____

Abandoned


Map No. Kansas Sec. 31 Twp. 24 R. 13
 Well No. 2 Carnish Farm
Christy et al Company

NORTH

WEST

EAST

SOUTH

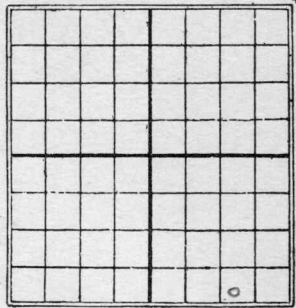

_____ Ft. from N. Line

120 Ft. from S. Line

1120 Ft. from E. Line

_____ Ft. from W. Line

Date

REPORT

1925

8/20 Rigging up

8/27 300'

9/3 700'

9/11 1235'

9/19 Sand 1500 Pay 1503-21

80 gts 25 Blbs Top Line 1600

1st Break 1612-1617 20 gts

15 Blbs

Map No. *Norman* **KANSAS** Sec. *31* Twp. *24* R. *13*

Well No. *2* *Carnish*
Christy et al Company

Contractor

FIRST REPORTS

SECTION PLAT

Note

			o

Ft. from N. Line

120

Ft. from S. Line

1120

Ft. from E. Line

Ft. from W. Line

this lease was formerly
owned by Bisagno et al.

Location

Rig up *machine*

Drilling and Remarks:

Bigging up

RECORD

Cased _____ in., _____ ft.

Sand _____

Gas _____

Oil _____

Total Depth _____

PRODUCTION

1st 24 hrs. Nat. _____

1st 24 hrs. after shot _____

Gas _____ Cu. Ft.

Dry Hole _____

Abandoned _____

Date

AUG 20 1925

192

CHAS. L. SHERWOOD

Scout

Map No. *KANSAS* Sec. *31* Twp. *24* R. *13*Well No. *D 2 Carnish**Christy at #1* Company _____

Contractor _____

COMPLETED

SECTION PLAT

_____ Ft. from N. Line

180 _____ Ft. from S. Line*1120* _____ Ft. from E. Line

_____ Ft. from W. Line

			o

Location _____

Rig up _____

Drilling and Remarks:

Boiler to 1500' pay
1503-1521' 80/125 bbls
Top line 1600' 1st
Bbls 1612-1617'
20/15 bbls. Producing
from both hands.

RECORD

Cased _____ in., _____ ft.

Sand _____

Gas _____

Oil _____

Total Depth *1617'*

PRODUCTION

1st 24 hrs. Nat. _____

1st 24 hrs. after shot. _____

Gas _____ Cu. Ft.

Dry Hole _____

Abandoned _____

Date

SEP 19 1925

CHAS. L. SHERWOOD

192

Scout