


Section 33 Township 25 Range 10 E

Well No. # 1 Dorickson

Company V. E. Stassen

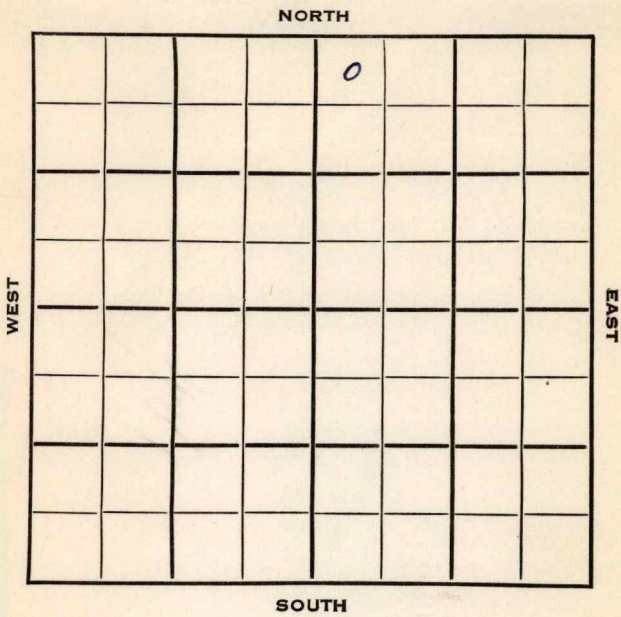

Greenwood

KANSAS


SEC.	TWP.	R.
33	25	10 E

WELL NO. # 1 Dorickson FARM

COMPANY V. E. Stassen

CONTRACTOR Sunflower Drlg.

Wildcat
 330 Ft. from N. Line
 _____ Ft. from S. Line
 _____ Ft. from E. Line
 330 Ft. from W. Line

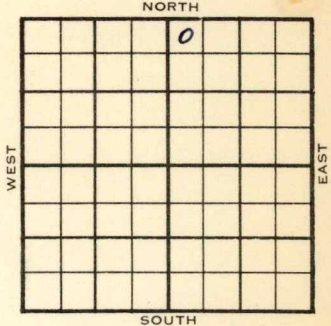

NW NW NE

1954	ELEVATION	REPORT
------	-----------	--------

5/19 Spud 5-12-54
 Miss 2017' TD 2064'
 D & A

FIRST REPORT
 ↙
ABANDONED

County Greenwood State Kansas

Sec. 33 (Blk. Twp.) 25 (Sur. Rge.) 10E Map No.

Operator V. E. Stassen

Well No. 1 Farm Dorickson

Elev. Location NW NW NE

		0			
FIRST REPORT					
ABANDONED					

330 Ft. From N Line NE

330 Ft. From W Line Quarter

Ist. Report MAY 19 1954

Completion MAY 19 1954

Remarks

Sunflower Drlg. - Contr.

Spudding Date 5-12-54

Drlg. Data Wilcat

Miss. 2017 TD 2064 D & A

J. G. McGEHEE