


Map No. Kansas Sec. 33 Twp. 25 R. 10
Well No. 1 Hammond Farm
Harri-Garrell Company

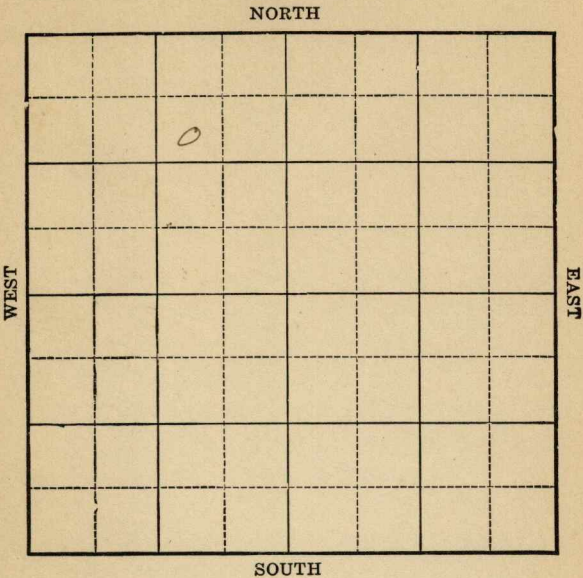

Location _____
Drilling Remarks _____

Rig Up _____
Drilling Remarks _____

RECORD

Cased _____ in. _____ ft.
Sand _____
Gas _____
Oil _____
Total Depth _____

PRODUCTION


1st 24 hrs. Nat. _____
1st 24 hrs. after shot _____
Gas _____ cu. ft.
Dry Hole _____
Abandoned _____

*Greenwood*Map No. *TRANS* Sec. *33* Twp. *25* R. *10*Well No. *1* *Hammond* Farm*Farr & Farrell* Company*990* Ft. from N. Line

Ft. from S. Line

990 Ft. from E. Line

Ft. from W. Line

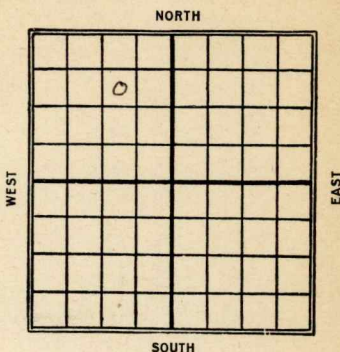*1926*

Date

REPORT

*7/31 Location**7/28 same**8/4**8/11 Spudding**8/18 Dlg 500**8/25 " 980**8-31 " 1250**9/15 " 1750**9/22 Top line 1994' - Dnlg**9/29 Top line 1994**12 & a 2125 feet*

Greenwood
 K16 KANSAS Sec. *33* Twp. *25* R. *10*
 Map No. *1* *Hammond*
 Well No. *Zann L Zannell*
 Company _____
 Contractor _____

FIRST REPORTS

SECTION PLAT

990 Ft. from N. Line
 _____ Ft. from S. Line
990 Ft. from E. Line
 _____ Ft. from W. Line

	o		

Location *✓* _____

Rig up _____

Drilling and Remarks:

RECORD

Cased _____ in., _____ ft.

Sand _____

Gas _____

Oil _____

Total Depth _____

PRODUCTION

1st 24 hrs. Nat. _____

1st 24 hrs. after shot. _____

Gas _____ Cu. Ft.

Dry Hole _____

Abandoned _____

Date

JUL 21 1926

192

CHAS. L. SHERWOOD

Scout

16 **KANSAS** 33 25 10
 Map No. Sec. Twp. R.

Well No. 1 Hammond
 Farrell & Farrell Company

Contractor

COMPLETED**SECTION PLAT**

990 Ft. from N. Line

Ft. from S. Line

990 Ft. from E. Line

Ft. from W. Line

ABANDONED

	0		

Location

Rig up

Drilling and Remarks:

TH 1994'

RECORD

Cased in., ft.

Sand

Gas

Oil

Total Depth 2125'

PRODUCTION

1st 24 hrs. Nat.

1st 24 hrs. after shot

Gas Cu. Ft.

Dry Hole ✓

Abandoned ✓

Date

SEP 20 1926

192

CHAS. L. SHERWOOD

Scout