

Map No. Kane Sec. 10 Twp. 24 R. 13

Well No. 1 Smith Farm

Chambers & Spencer Company

WEST

EAST

SOUTH

Rig Up.....

Drilling Remarks

PRODUCTION

1st 24 hrs. Nat. _____

1st. 24 hrs. after shot

Gas _____ cu. ft.

Dry Hole

Abandoned

Map No. 10 Sec. 10 Twp. 24 R. 13

Well No. 1 Smith Farm

Chambers & Spencer Company


NORTH

200 Ft. from N. Line

Ft. from S. Line

Ft. from E. Line

200 Ft. from W. Line

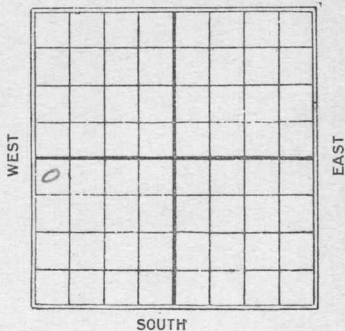

Date _____

1925

REPORT

3/1

Location

5/20

Abandoned 1736

Map No. 10 Sec. 10 Twp. 24 R. 13

Well No. 1 Smith
Chambers & Spencer Company

Contractor

FIRST REPORT

200 Ft. from N. Line

_____ Ft. from S. Line

_____ Ft. from E. Line

200 Ft. from W. Line

SECTION PLAT

0			

Location ✓✓

Rig up _____

Drilling and Remarks:

RECORD

Cased _____ in., _____ ft.

Sand _____

Gas _____

Oil _____

Total Depth _____

PRODUCTION

1st 24 hrs. Nat. _____

1st 24 hrs. after shot _____

Gas _____ Cu. Ft.

Dry Hole _____

Abandoned _____

Date

3/1 1925

M. A. BENTLEY Scout

Map No. 1544 Sec. 10 Twp. 24 R. 13Well No. 1 Smith
Chamber & Spencer Company

Contractor

COMPLETED

SECTION PLAT

200 Ft. from N. Line

Ft. from S. Line

Ft. from E. Line

200 Ft. from W. Line

ABANDONED

0			

Location

Rig up

Drilling and Remarks:

Top line 1631Dry & abo
101

RECORD

Cased _____ in., _____ ft.

Sand _____

Gas _____

Oil _____

Total Depth 1736'

PRODUCTION

1st 24 hrs. Nat. _____

1st 24 hrs. after shot _____

Gas _____ Cu. Ft.

Dry Hole ☒Abandoned ☒

Date

MAY 21 1925

192

CHAS. L. SHERWOOD

Scout