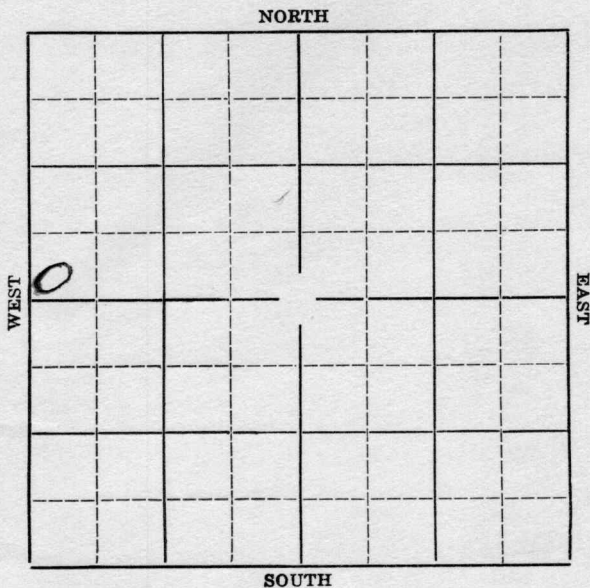


Section 15 Township 24 Range 13EWell Number #1 A. BoylesCompany Schull Drlg

Greenwood

Map No. KANSAS Sec. 15 Twp. 24 R. 13E


Well No. #1 "A" Boyles Farm
Schull Drlg. Company

 Ft. from N. Line

200' Ft. from S. Line

 Ft. from E. Line

200' Ft. from W. Line

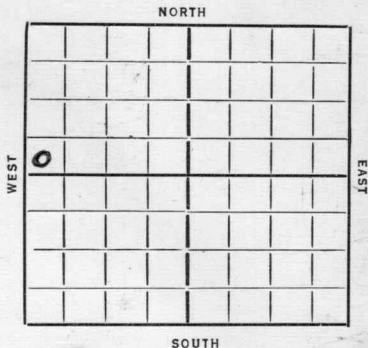

Date

REPORT

1936

6/3 Spud.

6/11 Drlg. 690'.

7/1/36-Miss. Lime. 1661'. TD 1711'.

Water. D & A

ABANDONED

Map No. 17 Sec. 15 Twp. 24 R. 13EWell No. 1 A Boyles.Schull J. G. Company

Contractor

SECTION PLAT

0			

_____ Ft. from N. Line

200 Ft. from S. Line

_____ Ft. from E. Line

200 Ft. from W. Line

FIRST REPORT

Location _____

Rig up _____

Drilling and Remarks:

Spud

RECORD

Cased _____ in., _____ ft.

Sand _____

Gas _____

Oil _____

Total Depth _____

PRODUCTION

1st 24 hrs. Nat. _____

1st 24 hrs. after shot _____

Gas _____ Cu. Ft.

Dry Hole _____

Abandoned _____

Date

JUN 3 1936

19

S. J. LEWIS

Scout

Map No. 17 Sec. 15 Twp. 24 R. 13EWell No. 1 A Boyles.Company Shull-Ing.

Contractor _____

SECTION PLAT

_____ Ft. from N. Line

200 Ft. from S. Line

_____ Ft. from E. Line

200 Ft. from W. Line

ABANDONED

Location _____

Rig up _____

Drilling and Remarks:

Miss Lewis 1661
Water

17A

RECORD

Cased _____ in., _____ ft.

Sand _____

Gas _____

Oil _____

Total Depth 1211

PRODUCTION

1st 24 hrs. Nat. _____

1st 24 hrs. after shot _____

Gas _____ Cu. Ft.

Dry Hole _____

Abandoned _____

Date

JUL 1 1936

19

S. J. LEWIS

Scout