


Section 15 Township 24 Range 13E

Well No. #1 Harris

Company R. E. Smith

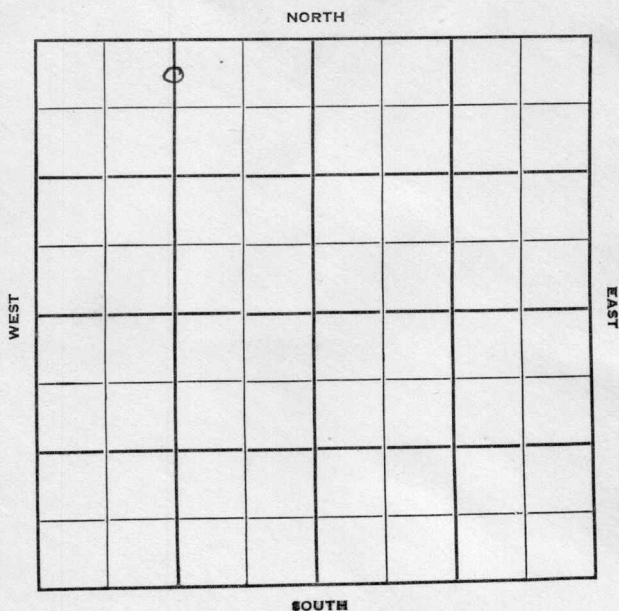

Greenwood KANSAS ✓

Sec. 15 Twp. 24 R. 13 E

Well No. # 1 Harris Farm

R. E. Smith Company

Contractor


330 Ft. from N. Line

_____ Ft. from S. Line

_____ Ft. from E. Line

1320 Ft. from W. Line

C N/2 N/2 NW

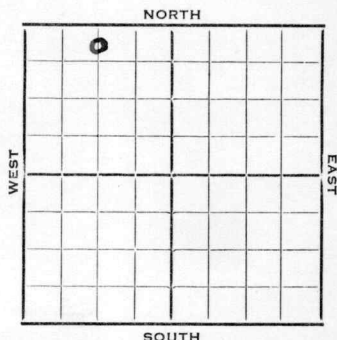

1952

Elev. -

REPORT

11/5

Spud 11-2-52

11/26

Spud 11-2-52

Oil Well

TD 1662'

10" @ 300

Miss 1637

TD 1654

5" @ 1654

DD 1662

Comp. 18 bopd

COMPLETED

County **Greenwood** State **Kansas**Sec. **15** (Blk.) **24** (Sur.) **13E** Map No.
(Twp.)Operator **R. E. Smith**Well No. **1** Farm **Harris**Elev. Location **C N $\frac{1}{2}$ N $\frac{1}{2}$ NW**

0							

FIRST REPORT

330 Ft. From **N** Line **NW****1320** Ft. From **W** Line Quarter1st. Report **NOV 5 1952**


Completion

Remarks

Spudding Date **11-2-52**

Drlg. Data

J. G. McGEHEE

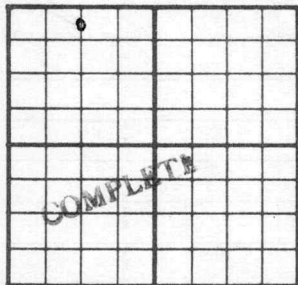County Greenwood State KansasSec. 15 (Blk.
Twp.) 24 (Sur.
Rge.) 13E Map No.Operator R. E. SmithWell No. 1 Farm HarrisElev. Location C N $\frac{1}{2}$ N $\frac{1}{2}$ NW330 Ft. From N Line NW1320 Ft. From W Line Quarter

1st. Report

Completion NOV 26 1952

Remarks

Spudding Date 11-2-52Drlg. Data Oil well TD 166210" @ 300 Miss. 1637 TD 16545" @ 1654 DD 1662 Comp. 18 bopd

J. G. McGEHEE