
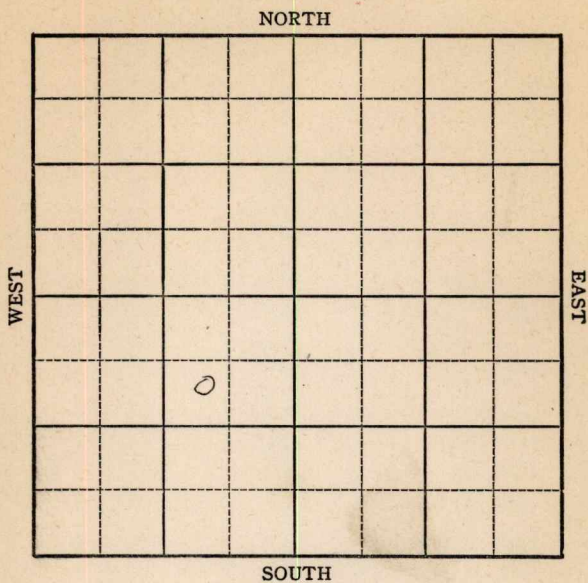


Section 36 Township 25 Range 9EWell No. #10Company Ind. Terr. Ill. Oil Co.

Map No. 37 Sec. 36 Twp. 25 R. 9
 Well No. 10 Farm _____
2.7.2 Company _____

NORTH

WEST

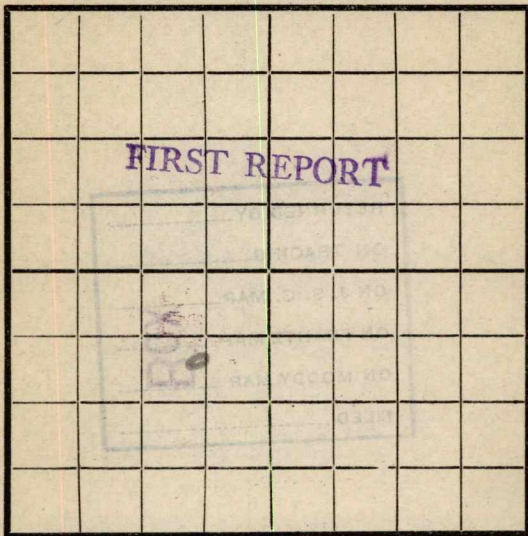

EAST

SOUTH

Location _____
 Rig Up _____
 Drilling and remarks

Reg

RECORD

Cased _____ in. _____ Ft.
 Sand _____
 Gas _____
 Oil _____
 Total Depth _____

PRODUCTION

1st 24 hrs. Nat. _____
 1st 24 hrs. after shot _____
 Gas _____ Cu. Ft.
 Dry Hole _____
 Abandoned _____

Date


4-20, 1918 Ross Scout

Map No. 57 Sec. 36 Twp. 25 R. 9

Well No. 20 Farm _____
2.4.22 Company _____

NORTH

WEST

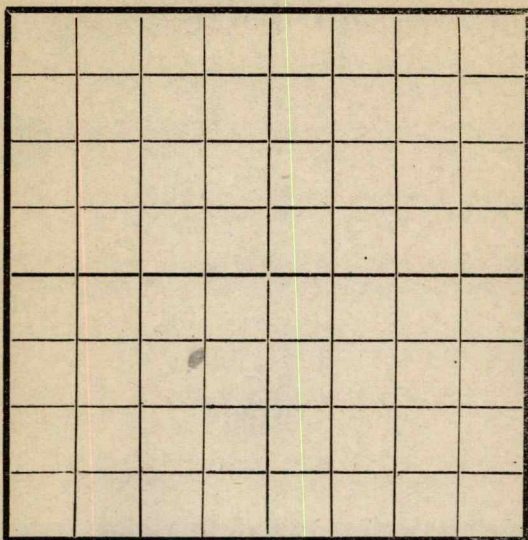

EAST

SOUTH

Location _____

Rig Up _____

Drilling and remarks

Deep
1330

RECORD

Cased _____ in. _____ Ft.

Sand _____

Gas _____

Oil _____

Total Depth _____

PRODUCTION

1st 24 hrs. Nat. _____

1st 24 hrs. after shot _____

Gas _____ Cu. Ft.

Dry Hole _____

Abandoned _____

Date

5-11, 1918 Perse Scout

Map No. 51 Sec. 36 Twp. 25 R. 9Well No. 10 Farm 2.7.200

Company _____

NORTH

WEST

EAST



SOUTH

Location _____

Rig Up _____

Drilling and remarks

shot
180 gts

RECORD

Cased _____ in. _____ Ft.

Sand 2032-2102

Gas _____

Oil _____

Total Depth 2102

PRODUCTION

1st 24 hrs. Nat. _____

1st 24 hrs. after shot 125

Gas _____ Cu. Ft.

Dry Hole _____

Abandoned _____

Date

5-17, 1918 *Ross*

Scout _____