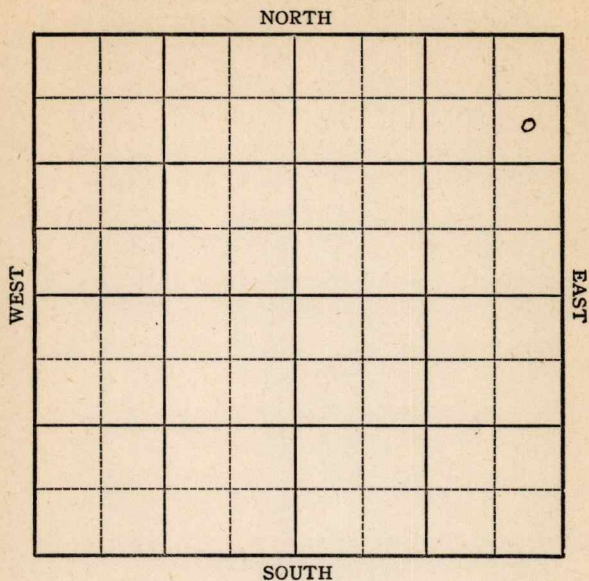


Section 36 Township 25 Range 9EWell No. #16Company Ind. Terr. Ill. Oil Co.

Map No. _____ Sec. 36 Twp. 25 R. 9Well No. 2 _____

_____ Company

_____ Contractor

FIRST REPORT

SECTION PLAT

810 Ft. from N. Line

_____ Ft. from S. Line

300 Ft. from E. Line

_____ Ft. from W. Line

Location _____

Rig up ☒ _____

Drilling and Remarks:

RECORD

Cased _____ in., _____ ft.

Sand _____

Gas _____

Oil _____

Total Depth _____

PRODUCTION

1st 24 hrs. Nat. _____

1st 24 hrs. after shot _____

Gas _____ Cu. Ft.

Dry Hole _____

Abandoned _____

Date

12/19 1919 9 Brenneman Scout

Map No. _____ Sec. 36 Twp. 25 R. 9Well No. 16 _____

_____ Company

_____ Contractor

SECTION PLAT

810 Ft. from N. Line

_____ Ft. from S. Line

300 Ft. from E. Line

_____ Ft. from W. Line

Location _____

Rig up _____

Drilling and Remarks:

No #3

RECORD

Cased _____ in., _____ ft.

Sand _____

Gas _____

Oil _____

Total Depth _____

PRODUCTION

1st 24 hrs. Nat. _____

1st 24 hrs. after shot _____

Gas _____ Cu. Ft.

Dry Hole _____

Abandoned _____

Date

1/20 1910 Brenneth Scout

Map No. _____ Sec. 36 Twp. 25 R. 9Well No. 16 _____

_____ Company

_____ Contractor

SECTION PLAT

Completion

810 _____ Ft. from N. Line

_____ Ft. from S. Line

300 _____ Ft. from E. Line

_____ Ft. from W. Line

Location _____

Rig up _____

Drilling and Remarks:

RECORD

Cased 6 7/8 in. 1950 ft.Sand 1960-1985

Gas _____

Oil _____

Total Depth _____

PRODUCTION

1st 24 hrs. Nat. _____

1st 24 hrs. after shot _____

Gas _____ Cu. Ft.

Dry Hole _____

Abandoned _____

Date

1/31 1970 Brennake Scout