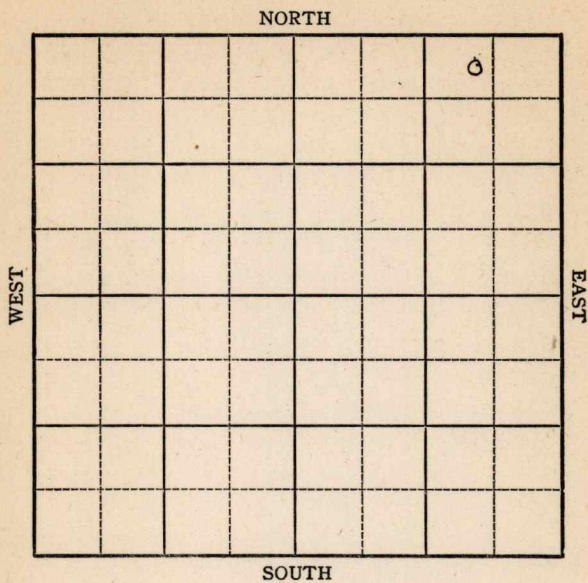


Section 36 Township 25 Range 9EWell No. #17Company Ind. Terr. Ill. Oil Co.

Map No. _____ Sec. 36 Twp. 25 R. 9

Well No. 17 _____ Farm _____


J. J. J. Co. _____ Company

300 Ft. from N. Line

_____ Ft. from S. Line

810 Ft. from E. Line

_____ Ft. from W. Line

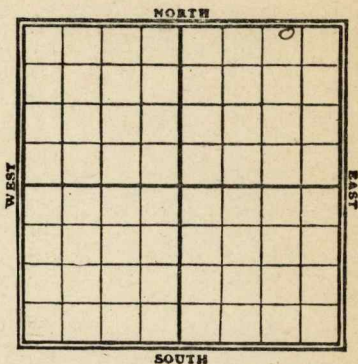

Date 6-20

REPORT

FIRST REPORT

<u>1/17</u>	<u>Rig up.</u>
<u>21</u>	<u>Rigger up</u>
<u>26</u>	<u></u>
<u>7/14</u>	<u>1958' - 64' - 600' oil well</u> <u>so far pure</u>
<u>21</u>	<u>6578' - 1956' - to about</u> <u>1985' - 2021' 17095</u>
<u>28</u>	<u>1985' - 2021' - 170/125B</u>

COMPLETED

Map No. _____ Sec. 36 Twp. 35 R. 9Well No. 17 _____555040 _____ Company

_____ Contractor

FIRST REPORT

SECTION PLAT

			0

300 Ft. from N. Line

_____ Ft. from S. Line

80 Ft. from E. Line

_____ Ft. from W. Line

Location _____

Rig up ☒ _____

Drilling and Remarks:

RECORD

Cased _____ in., _____ ft.

Sand _____

Gas _____

Oil _____

Total Depth _____

PRODUCTION

1st 24 hrs. Nat. _____

1st 24 hrs. after shot _____

Gas _____ Cu. Ft.

Dry Hole _____

Abandoned _____

Date

1/17 191 W. Brenneke Scout

Map No. _____ Sec. 36 Twp. 25 R. 9Well No. 37 _____

_____ Company

_____ Contractor

SECTION PLAT

			0

Completion

300 Ft. from N. Line

_____ Ft. from S. Line

810 Ft. from E. Line

_____ Ft. from W. Line

Location _____

Rig up _____

Drilling and Remarks:

Shot 170 gals

RECORD

Cased _____ in., _____ ft.

Sand 1985-2021

Gas _____

Oil _____

Total Depth 2023

PRODUCTION

1st 24 hrs. Nat. _____

1st 24 hrs. after shot 125

Gas _____ Cu. Ft.

Dry Hole _____

Abandoned _____

Date

2/28 191 20 AMP Scout