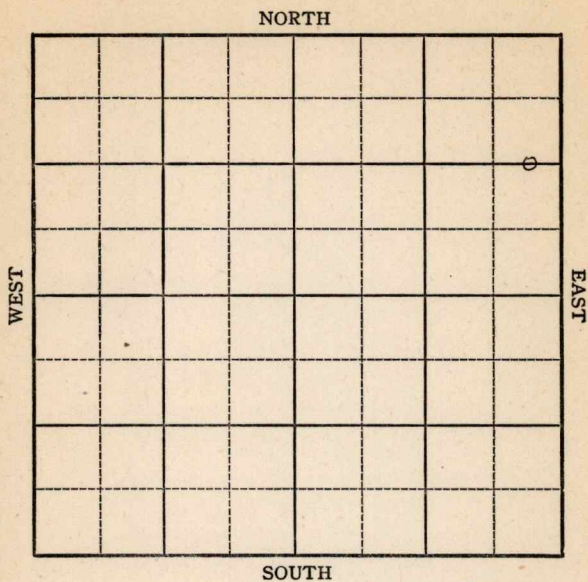


Section 36 Township 25 Range 9EWell No. #18Company Ind. Terr. Ill. Oil Co.

Map No. _____ Sec. 56 Twp. 35 R. 9


Well No. 18 Farm _____
J. G. & Co., Company _____

1320 Ft. from N. Line

_____Ft. from S. Line

300 Ft. from E. Line

Ft. from W. Line

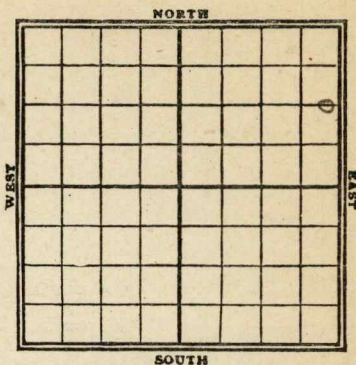

1920 Date REPORT

2/7	Rig up -
-----	----------

14	Rij
21	-

29 10

3/5	Ring in
27	600'

27	600'
----	------

4/2, 1970-2004 $2^{10}/100$ good for 100 -

4/13	Sum 1970-2004- Sheet 2 of 35 bpls -
------	-------------------------------------

FIRST REPORT

COMPLETE

Map No. 51 Sec. 36 Twp. 25 R. 9

Well No. 18

5750

Company _____ Contractor _____

SECTION PLAT

FIRST REPORT

_____ Ft. from N. Line
_____ Ft. from S. Line
_____ Ft. from E. Line
_____ Ft. from W. Line

Location _____

Rig up ☒ _____

Drilling and Remarks:

RECORD

Cased _____ in., _____ ft.
Sand _____
Gas _____
Oil _____
Total Depth _____

PRODUCTION

1st 24 hrs. Nat. _____
1st 24 hrs. after shot _____
Gas _____ Cu. Ft.
Dry Hole _____
Abandoned _____

Date 7/7 1920 AMB Scout

Map No. 57 Sec. 36 Twp. 25 R. 9Well No. 18J. J. O. Company

Contractor

SECTION PLAT


Completion

1320 Ft. from N. Line

Ft. from S. Line

300 Ft. from E. Line

Ft. from W. Line

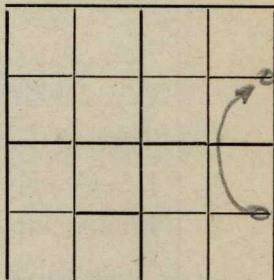

Location

Rig up

Drilling and Remarks:

shot 210 / 35

RECORD

Cased _____ in., _____ ft.

Sand 1970-2004

Gas _____

Oil _____

Total Depth _____

PRODUCTION

1st 24 hrs. Nat. _____

1st 24 hrs. after shot _____

Gas _____ Cu. Ft.

Dry Hole _____

Abandoned _____

Date

4/13/20 MB Scout